


T.4S., R.2E., W.M.

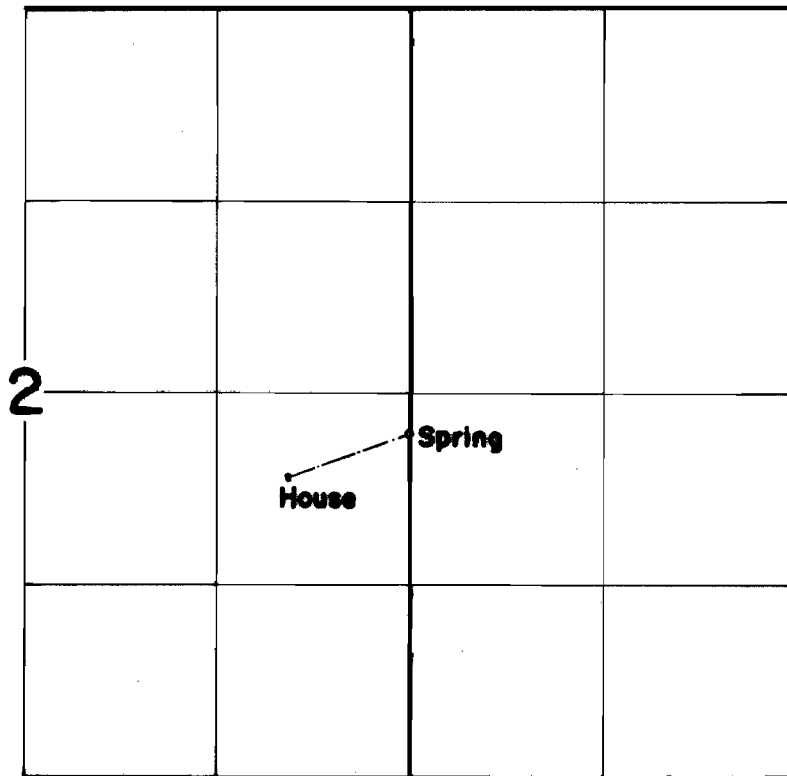

SPRING LOCATED: 270'S & 5' W FROM E $\frac{1}{4}$ COR SEC. 2.

FINAL PROOF SURVEY
UNDER

Application No. 49438 Permit No. 37037
IN NAME OF

WILLIAM L. AND ESSIE P. GEREN

Surveyed Sept. 5 1974, by R. Dorby