


T.25S.R.IIW.W.M.

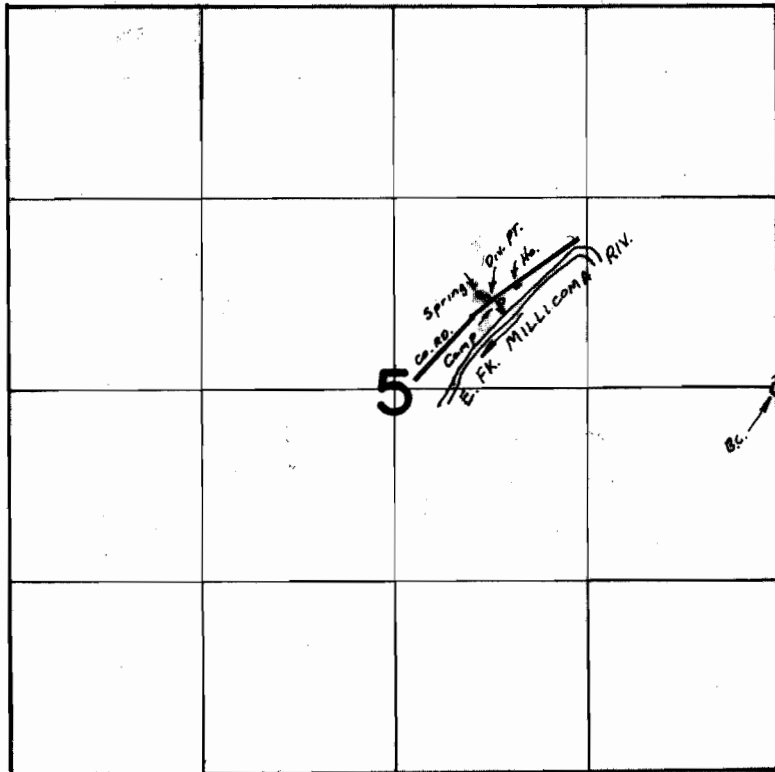

SPRING LOC. 680' N. & 2050' W.,
DIV. PT. LOC. 640' N. & 1990' W.,
BOTH FROM E. 1/4 COR. SEC. 5.

FINAL PROOF SURVEY UNDER

Application No. 45711 Permit No. 34102
IN NAME OF

FRANK HUSTEAD & ILMAR KOIVUNEN

Surveyed JUL 30 1974, by L.H. NUNN