


T.26S.R.14W.W.M.

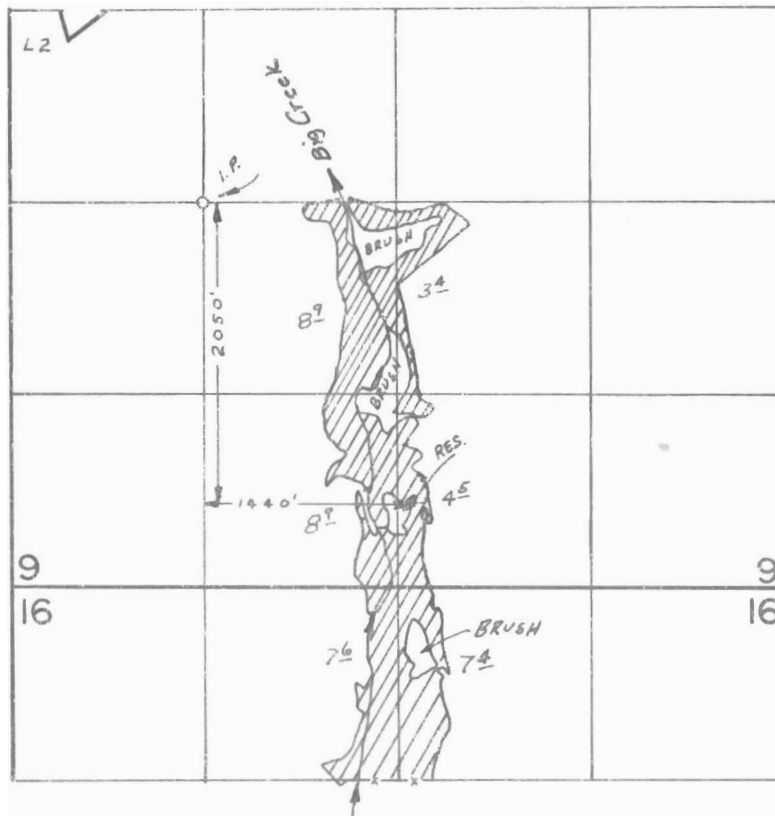

FINAL PROOF SURVEY UNDER

46598 34825
Application No. R-46713 Permit No. R-5579
IN NAME OF

BIG CREEK VALLEY, INC.

Surveyed JUL 29 1974 by L.H. NUNN