


# T.26S.R.14W. W.M.

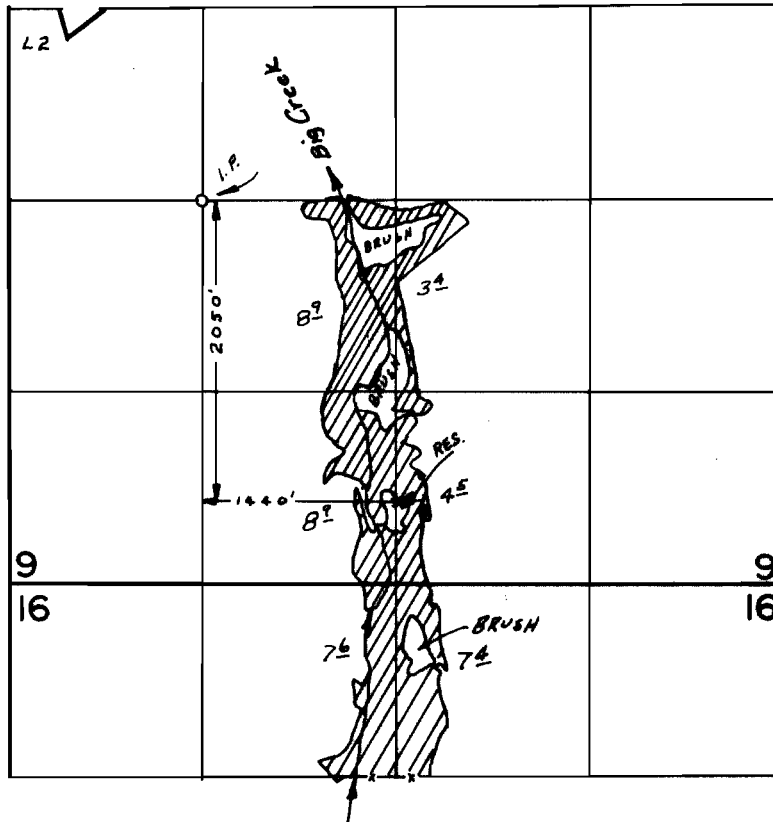

## FINAL PROOF SURVEY UNDER

46598                      34825  
Application No. R-46713 Permit No. R-5579  
IN NAME OF

BIG CREEK VALLEY, INC.

Surveyed JUL 29 1974, by L.H. NUNN