


T. 28S. R. 13W. M.

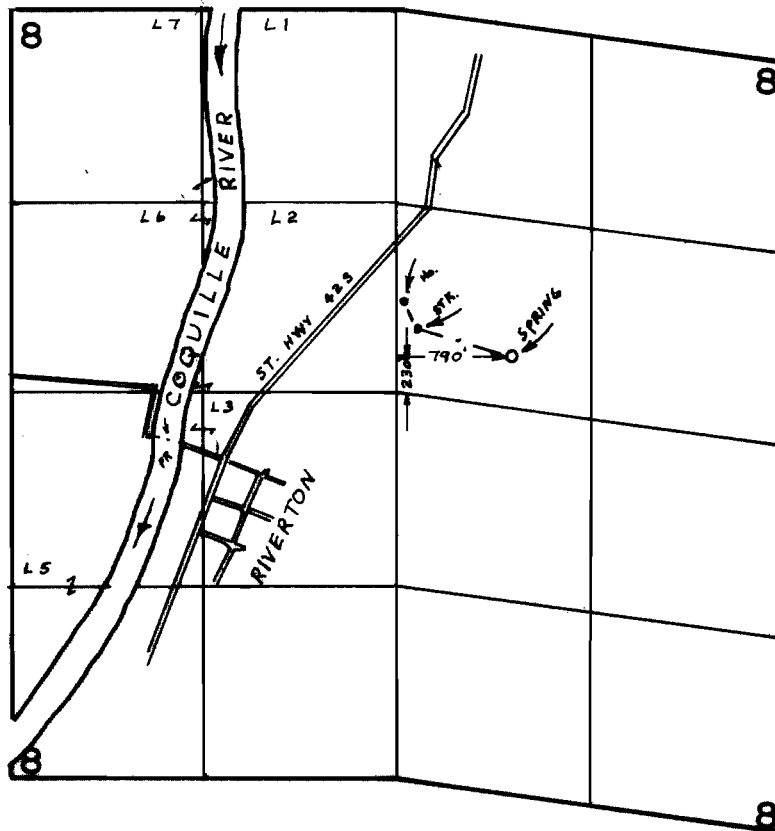

FINAL PROOF SURVEY
UNDER

Application No. 49005 Permit No. 36685
IN NAME OF

CLAUD P. & BETTY SLAUGHTER

Surveyed AUG. 1, 1974, by L.H. NUNN