


T.24S.,R.5W.,W.M.

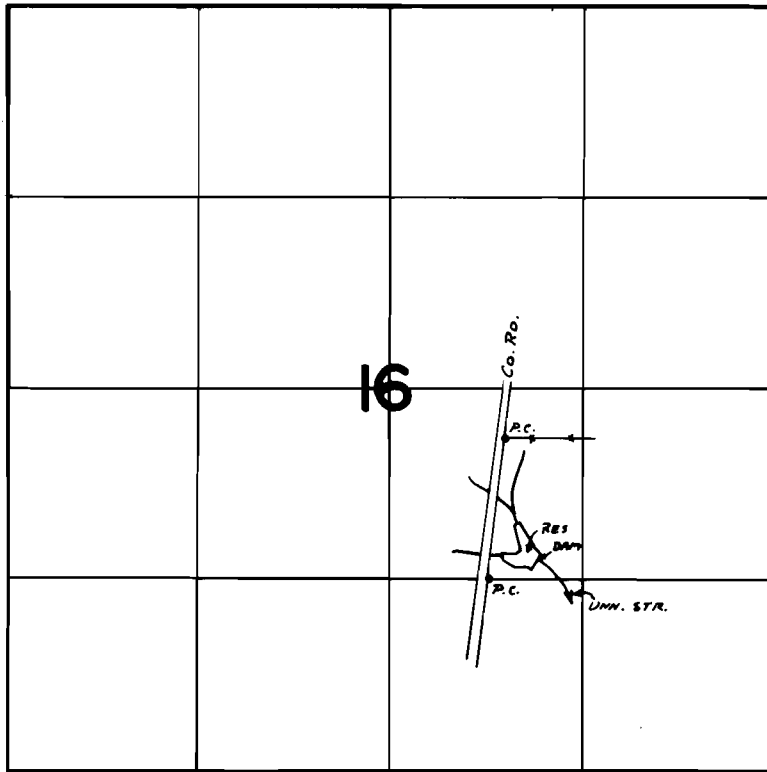

FINAL PROOF SURVEY
UNDER

Application No. ~~R-49697~~ Permit No. ~~R-6041~~
IN NAME OF

.....KENNETH L. WOLFER.....

Surveyed ~~JUNE 3~~ 19~~75~~, by ~~L. E. Goulo~~.....