


T.27S. R.5W. W.M.

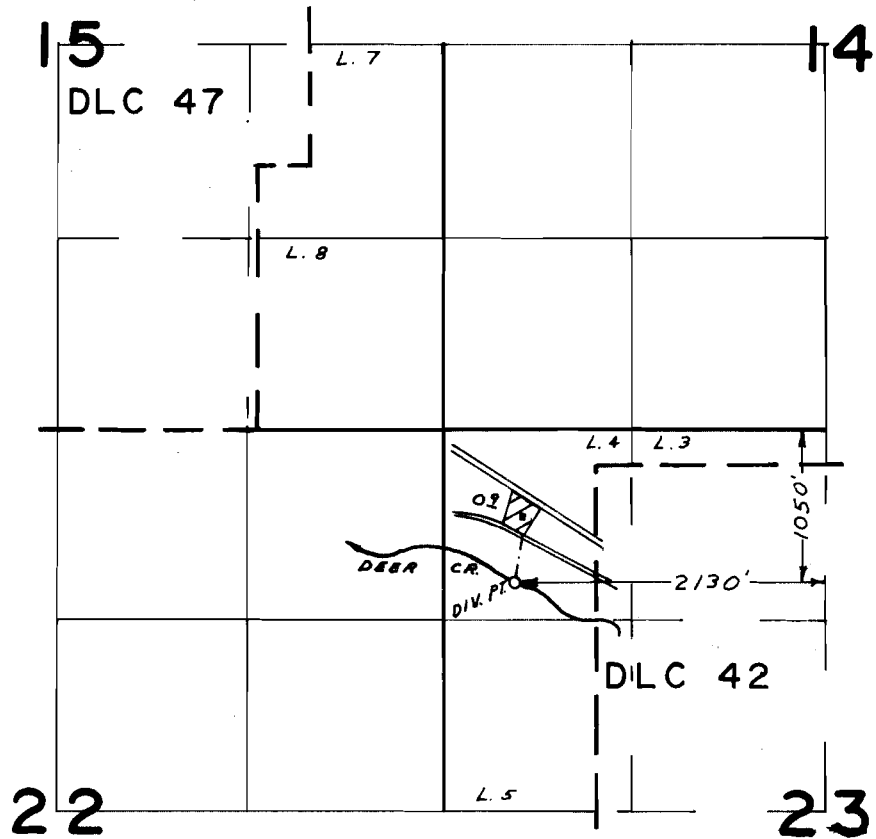

FINAL PROOF SURVEY UNDER

Application No. 44009 Permit No. 32900
IN NAME OF

CARL WESTFALL

Surveyed MAR. 24. 1975. by L.H. NUNN