


T.20S., R.12W., W.M.

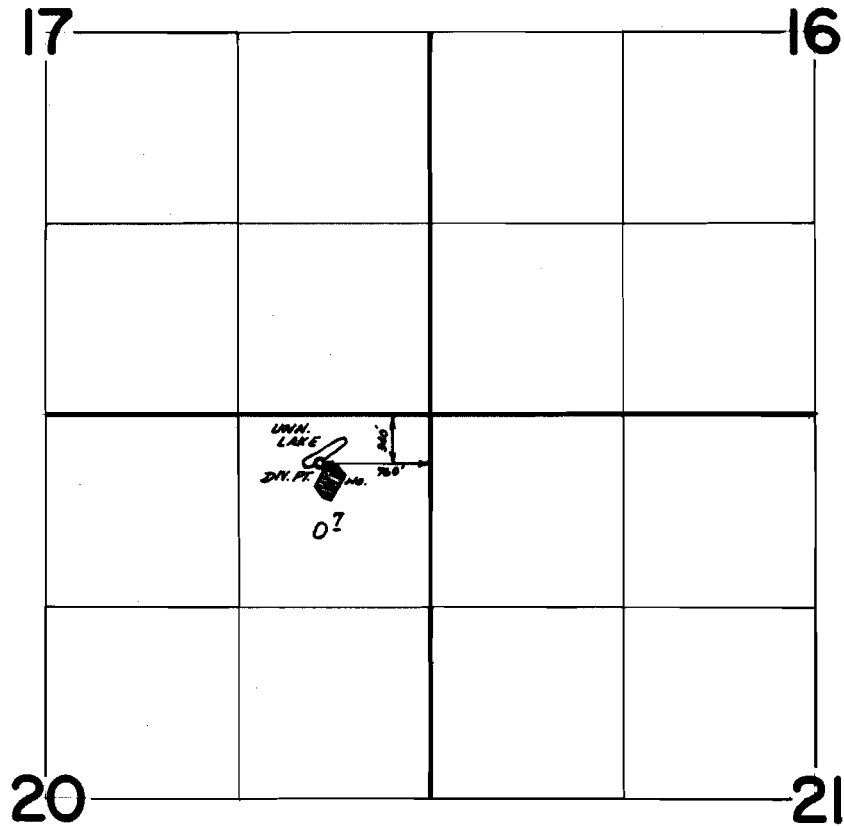

FINAL PROOF SURVEY
UNDER

Application No. 46219 Permit No. 34532
IN NAME OF

LOUISA E. SLONECKER

Surveyed July 22 1975, by D. Norby