


T.30S. R.2W. W.M.

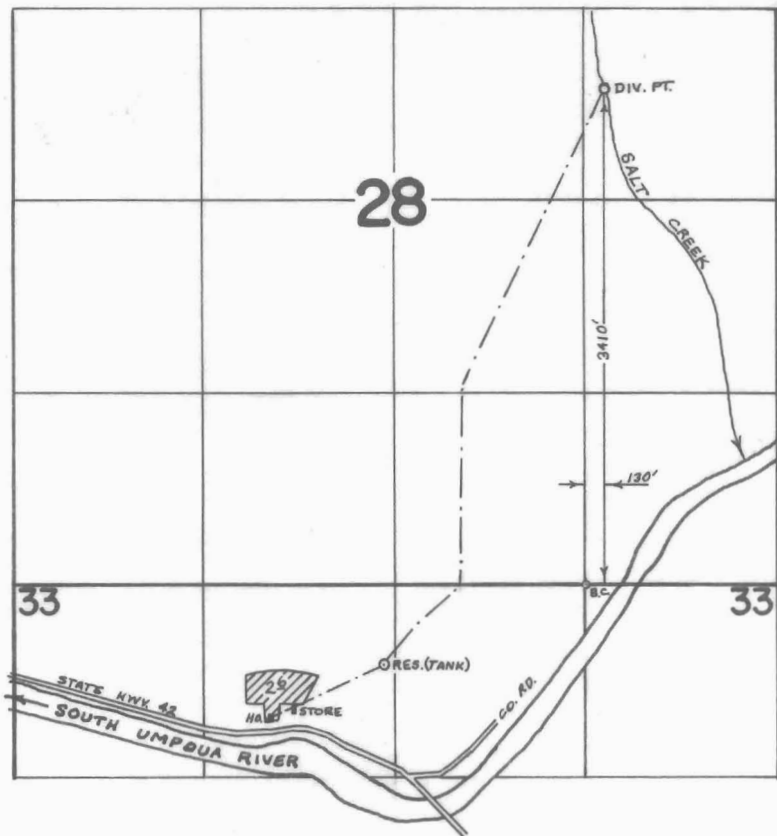

FINAL PROOF SURVEY
UNDER

Application No. 46810..... Permit No. 35006.....
IN NAME OF

JANE PORTER

Surveyed MAY 21 1975, by L. TOLL.....