


T.32S. R.5W. W.M.

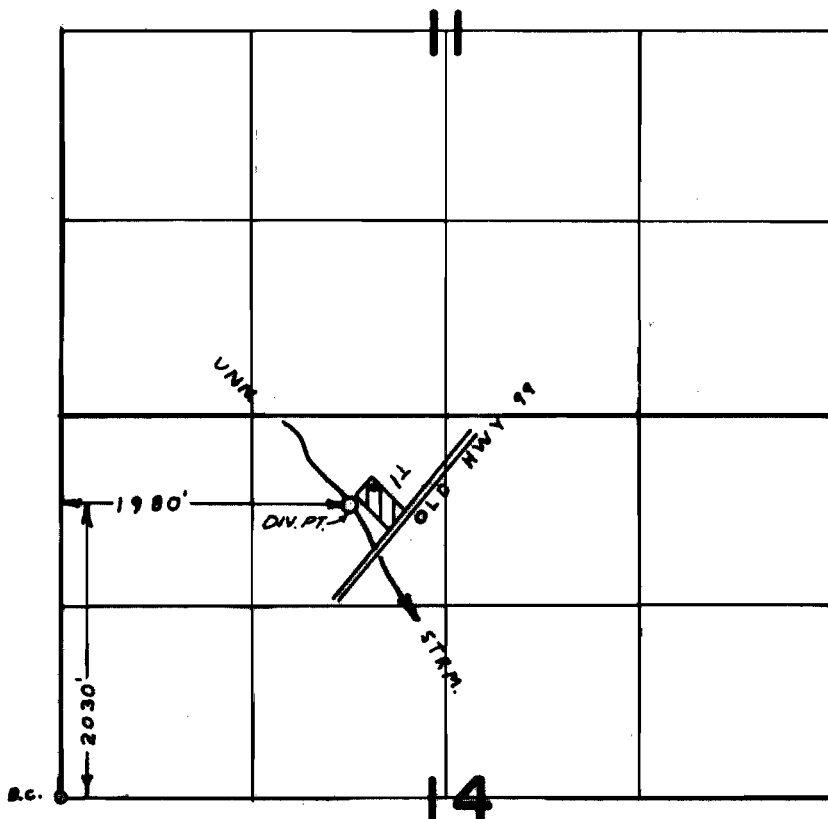

FINAL PROOF SURVEY
UNDER

Application No. 47193 Permit No. 35354
IN NAME OF

T.V. WILKINS

Surveyed MAY 23 1975, by L H NUNN