


T.26S. R.4W. W.M.

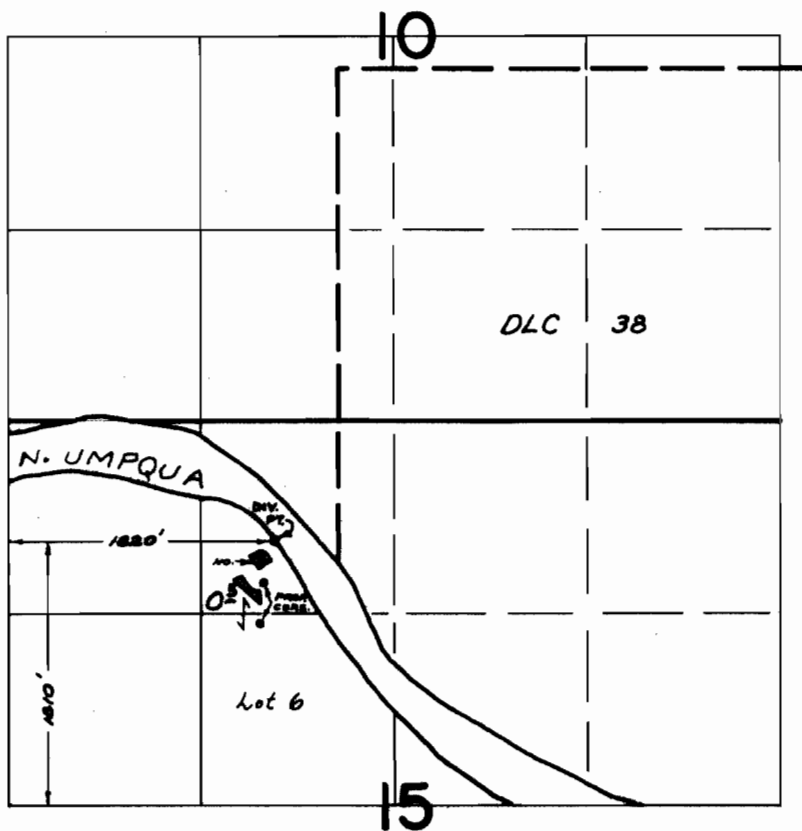

FINAL PROOF SURVEY UNDER

Application No. 47227 Permit No. 35378
IN NAME OF

W. STANLEY & YVONNE M. KNOUSE

Surveyed SEPT. 16, 1975, by R. MUCKEN