


# T.30S. R.3W. W.M

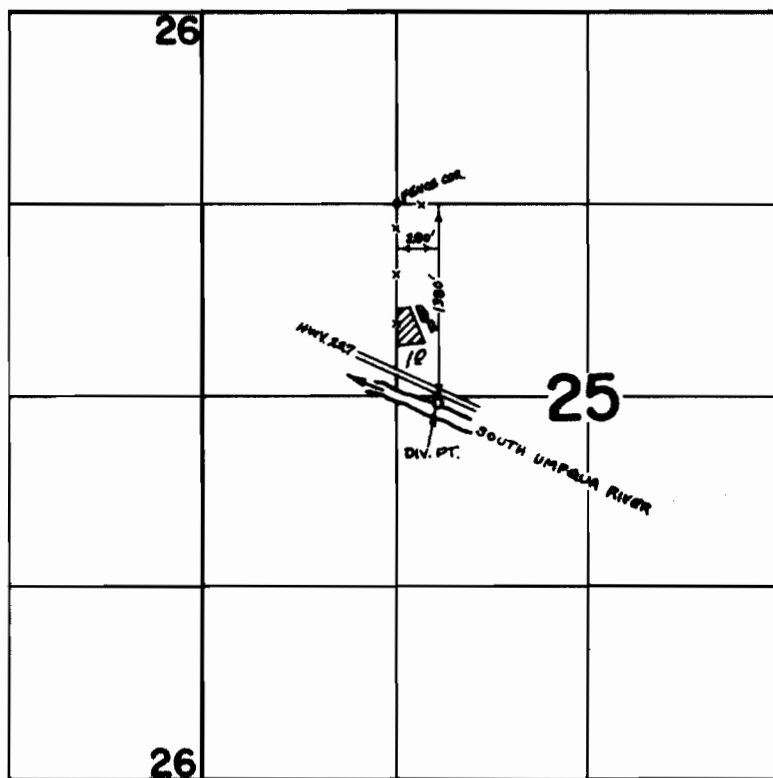

## FINAL PROOF SURVEY UNDER

Application No. 49120..... Permit No. 36835.....  
IN NAME OF  
DOUGLAS, SUSAN, & GLOCKNER SALISBURY,  
FRANCIS H. & MAE REA.....

Surveyed MAY 22 1975, by L. TOLL.....