


T.27S. R.6W. W.M.

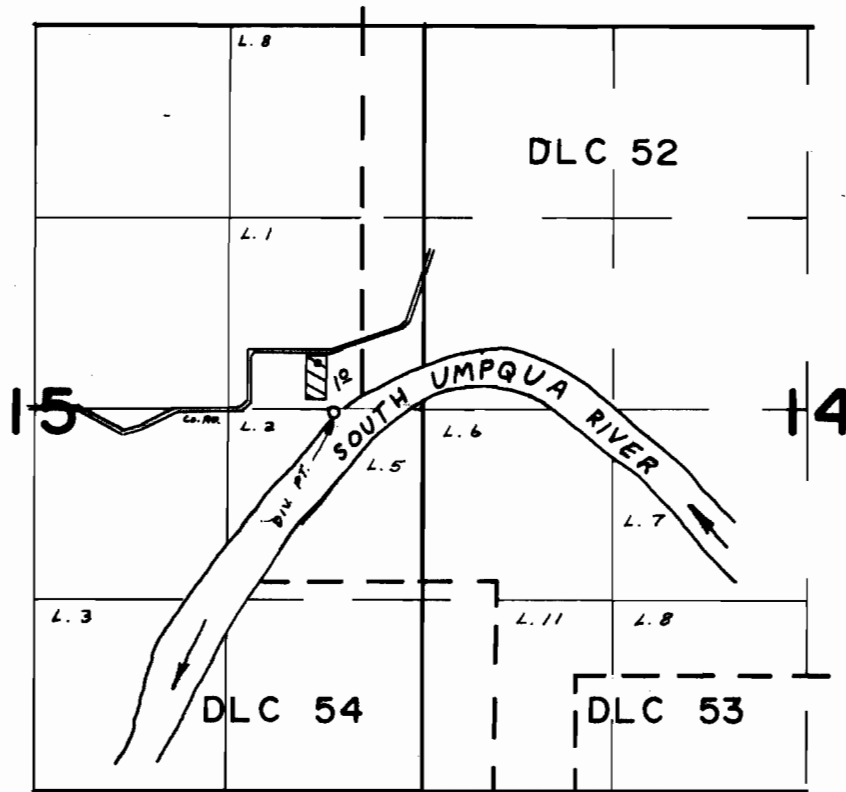

DIV. PT. LOC. 2060' E & 30' S FROM CENTER SEC. 15

FINAL PROOF SURVEY
UNDER

Application No. 49334 Permit No. 36984
IN NAME OF

LYLE F. MOCK

Surveyed MAR. 24 1975. by L.H. NUNN