


T.29S., R.5W., W.M.

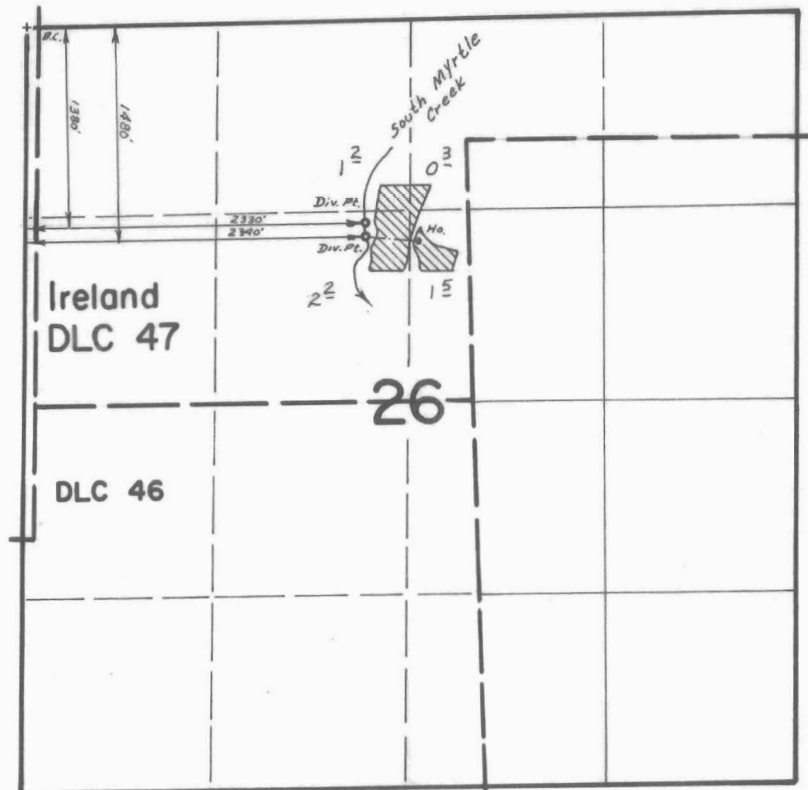

FINAL PROOF SURVEY
UNDER

Application No. 49508 Permit No. 37106
IN NAME OF

MR. AND MRS. JEROME WILSON

Surveyed Nov. 5 1975, by D. Norby