


T.29S.,R.6W.,W.M.

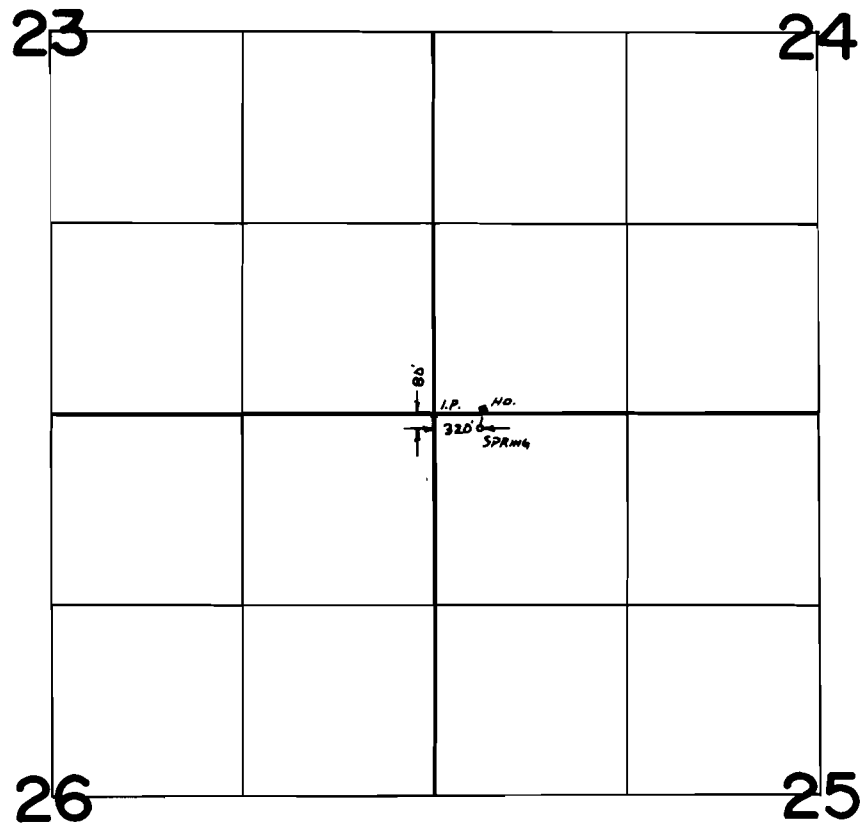

FINAL PROOF SURVEY
UNDER

Application No. 49709 Permit No. 37235
IN NAME OF

BOYD NELSON

Surveyed JULY 25 1975, by L. E. GOULD