


T.26S., R.6W., W.M.

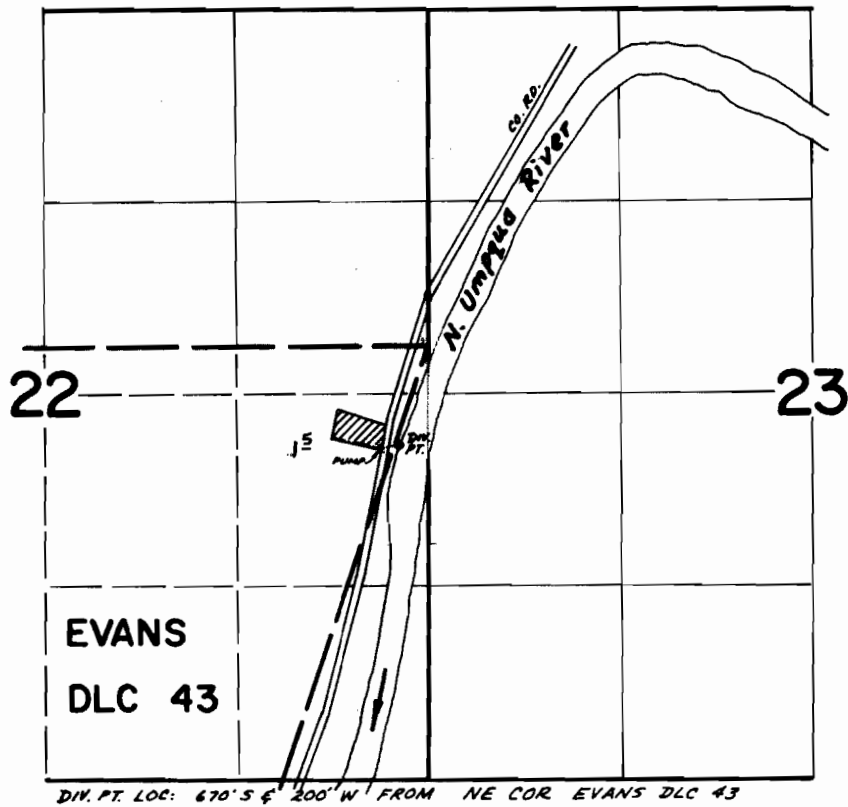

FINAL PROOF SURVEY
UNDER

Application No. 50114 Permit No. 37658
IN NAME OF

FRED V. SKEELS

Surveyed NOV. 6 1975, by D. NORBY