


T.28S.,R.6W.,W.M.

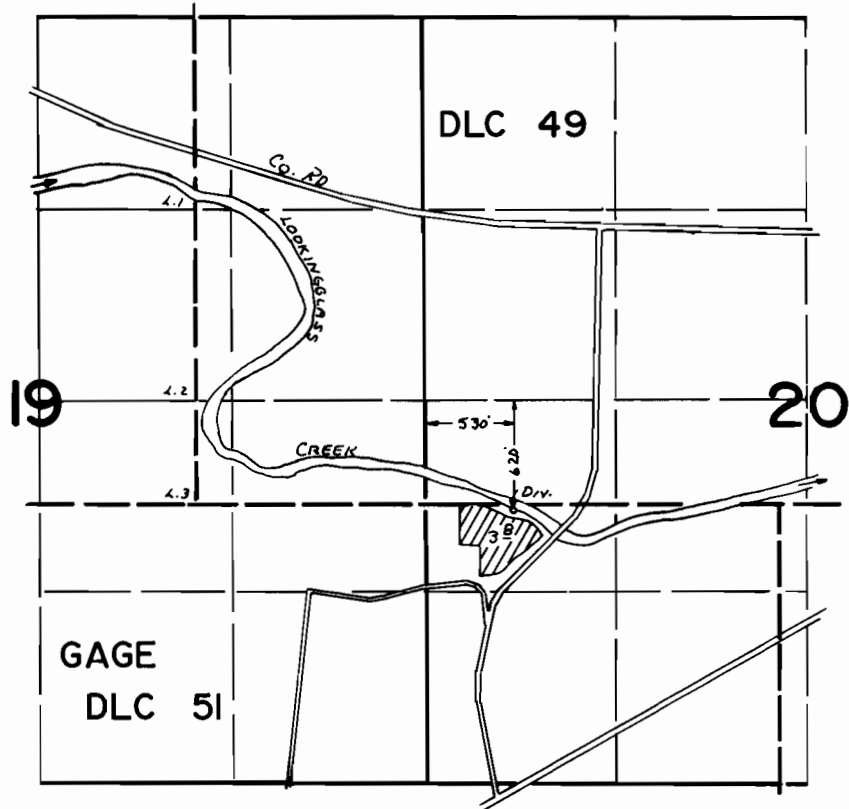

FINAL PROOF SURVEY
UNDER

Application No. 50188 Permit No. 37693
IN NAME OF

CHARLIE W. WALKER

Surveyed JULY 21 1975, by A. E. GAULD