


T.27S. R.3W. W.M.

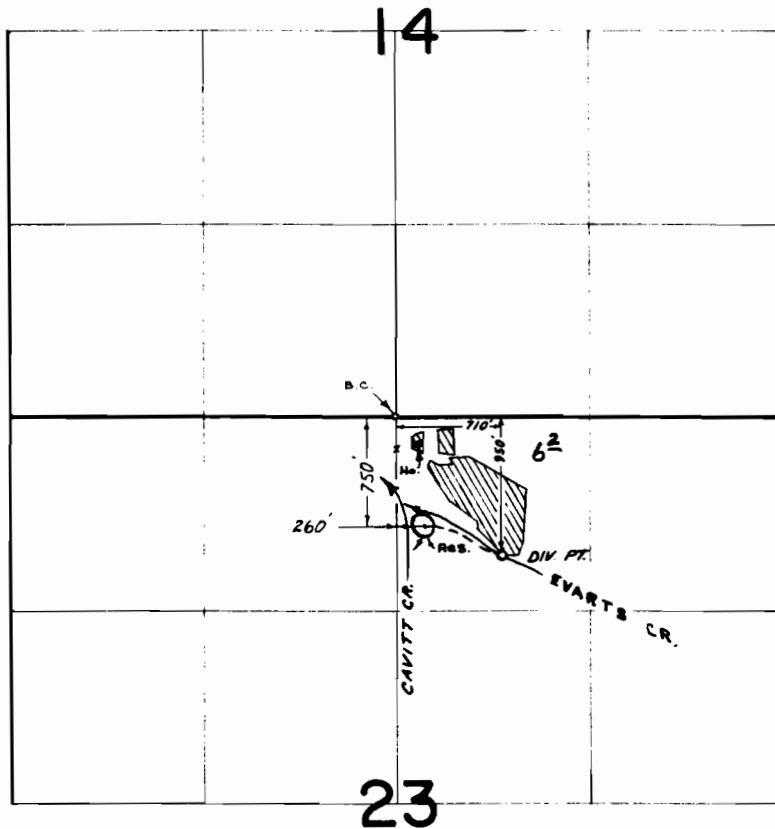

FINAL PROOF SURVEY
UNDER

Application No. 52242 Permit No. 37767
R-52650 R-6115
IN NAME OF

W. E. & JOAN CORRELL

Surveyed SEPT. 19, 1975, by R. MUCKEN