


T.27S. R.3W. W.M.

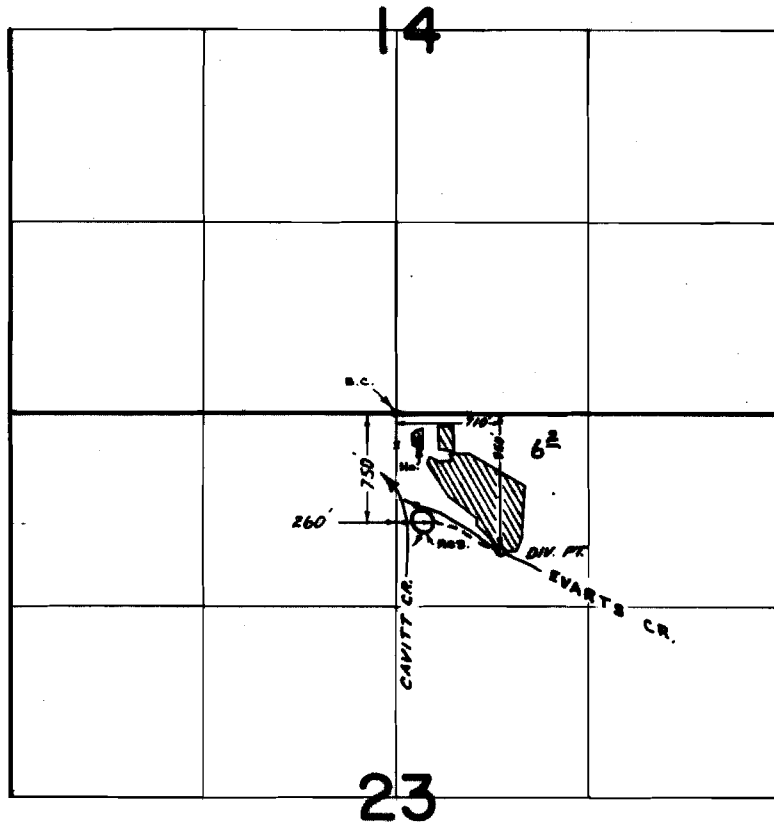

**FINAL PROOF SURVEY**  
UNDER

Application No. 52242 Permit No. 37767  
R-52650 R-6115  
IN NAME OF

W. E. & JOAN CORRELL

Surveyed SEPT. 19. 19 75, by R. MUCKEN