


T. 38 S. R. 1 W. W. M.

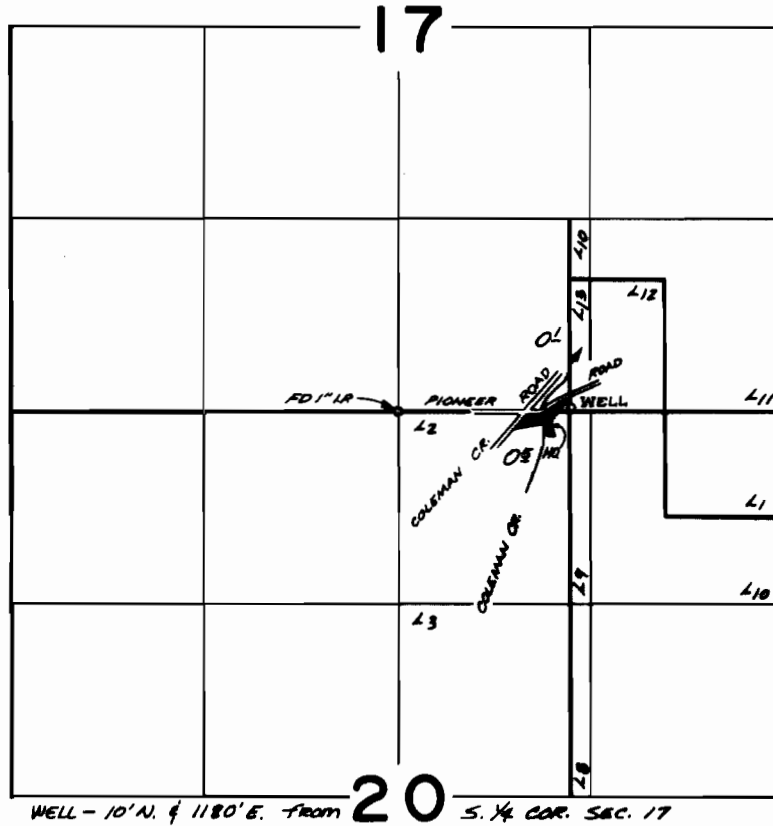

**FINAL PROOF SURVEY**  
UNDER

Application No. G 4874 Permit No. G 4589  
IN NAME OF

DAVID J. GIBSON

Surveyed JULY 15, 1974, by L.M.TOLL