


T. 39S. R. 3W. W.M.

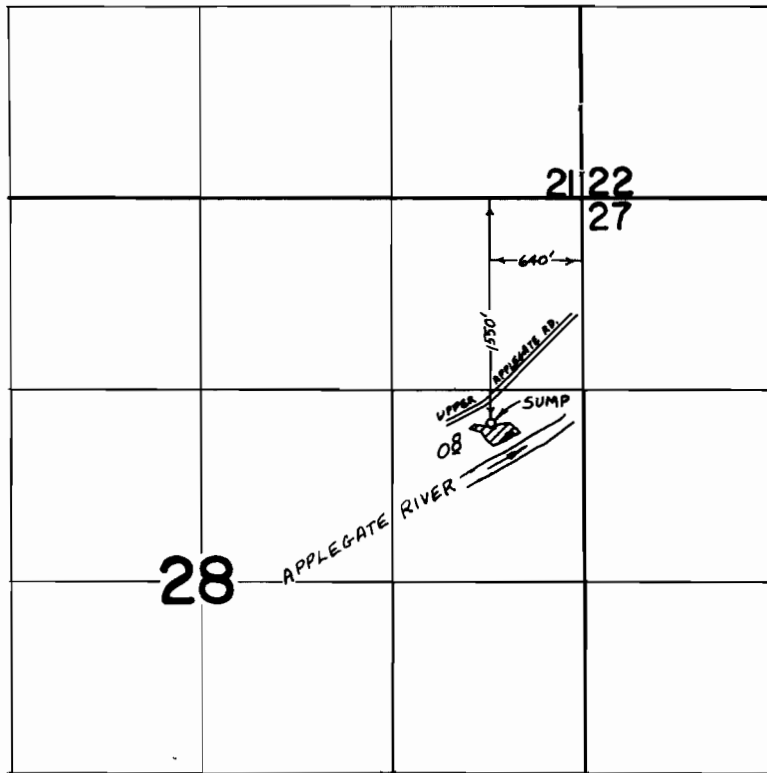

FINAL PROOF SURVEY
UNDER

Application No. G-5470 Permit No. G-5378
IN NAME OF

GEORGE P. MAYO

Surveyed NOV. 5 1975, by L. TOLL