


T.35S. R.4W. W.M.

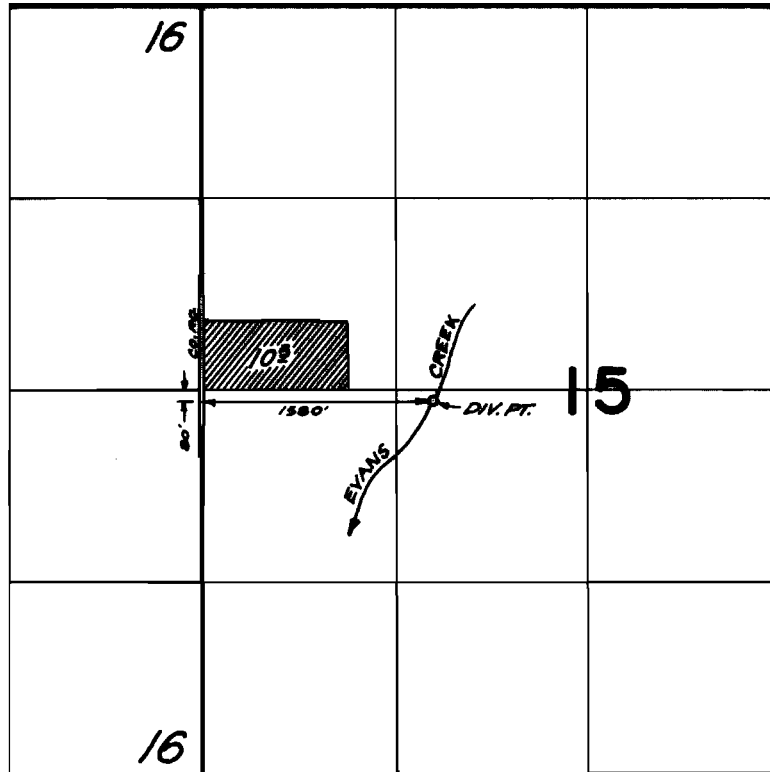

FINAL PROOF SURVEY
UNDER

Application No. 10887... Permit No. 304-76...
IN NAME OF

ELEANORE GOLDEN

Surveyed JULY 25 1974, by D. NORBY.....