


T.37S.R.3E.W.M.

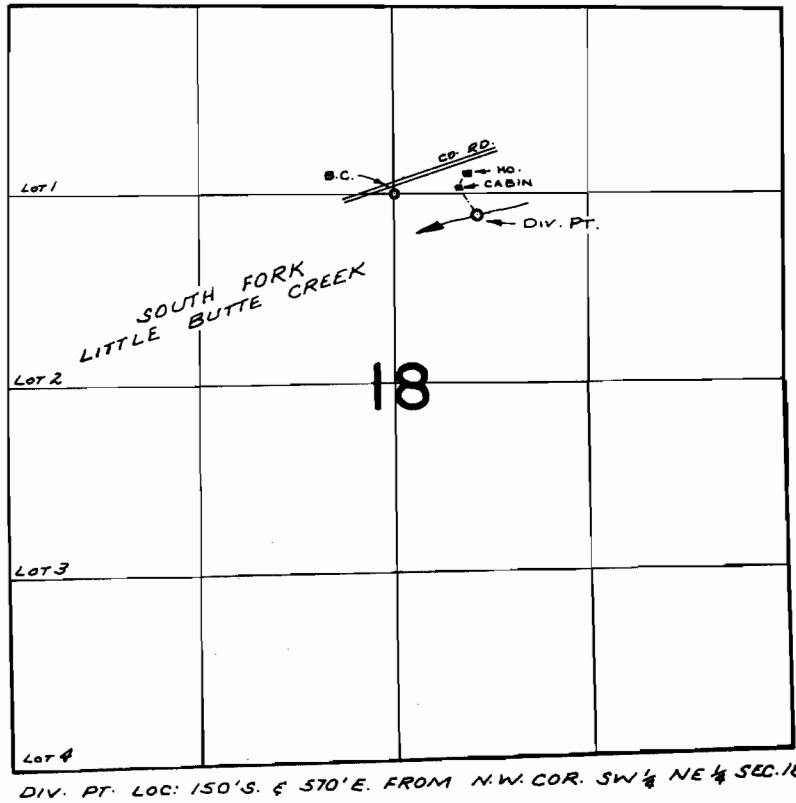

FINAL PROOF SURVEY
UNDER

Application No. 47962 Permit No. 35977
IN NAME OF

LOYD A. GEORGE

Surveyed JUNE 5, 1974, by R. MUCKEN