


T.33S.R.1E.W.M.

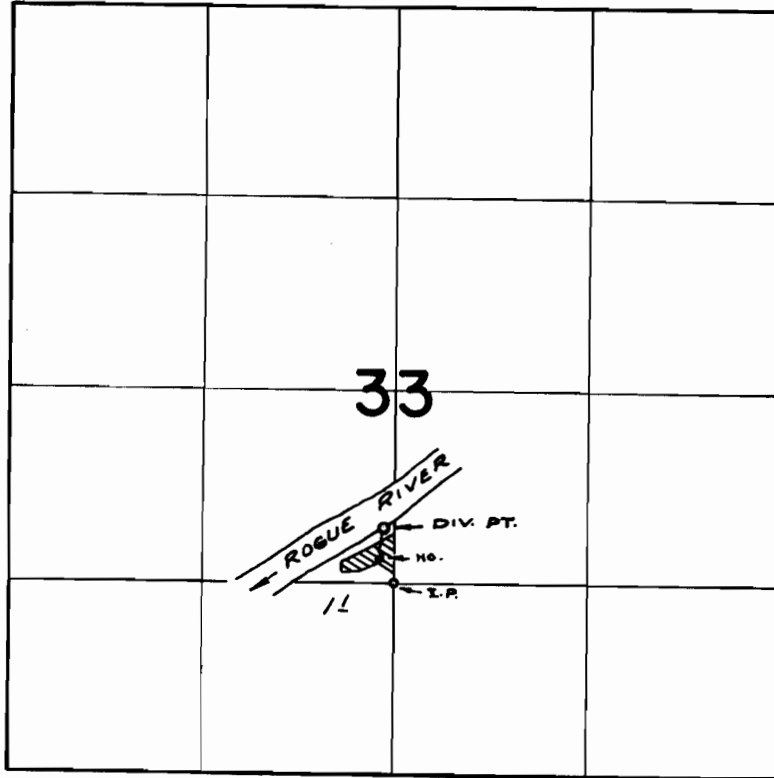

DIV. PT. LOC: 380' N. & 70' W. FROM S.E. COR. N.E.  $\frac{1}{4}$  SW  $\frac{1}{4}$  SEC. 33

**FINAL PROOF SURVEY**  
UNDER

Application No. 42261..... Permit No. 36764....  
IN NAME OF

.....W. H. LEEVER.....

Surveyed JUNE 11, 1974, by R. MUCKEN.