


T.36S.,R.4W.,W.M.

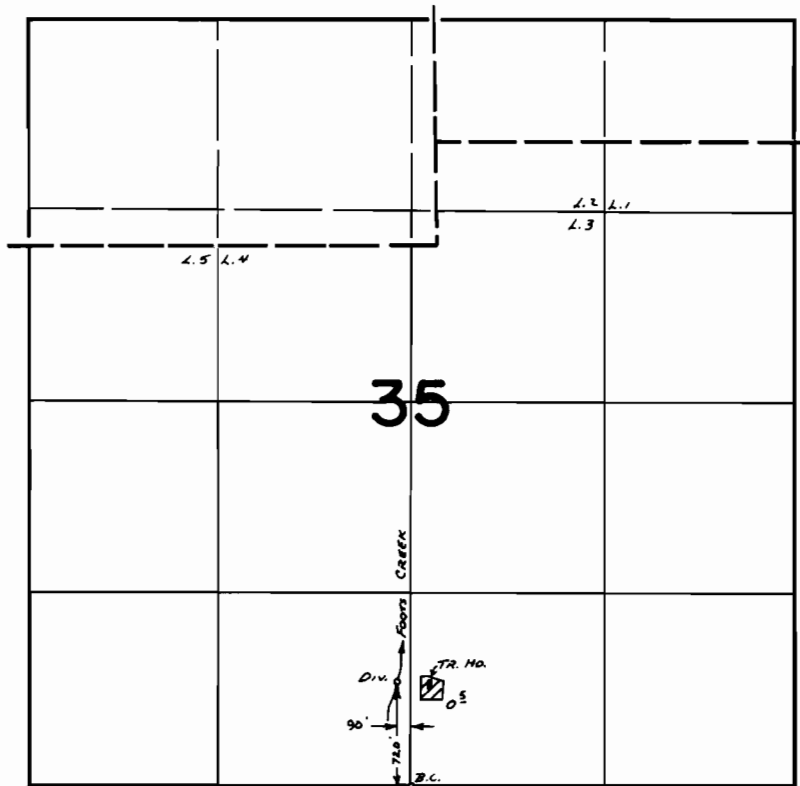

FINAL PROOF SURVEY UNDER

Application No. 50047. Permit No. 37621.
IN NAME OF

JOHN J. WILLIAMSON

Surveyed Aug. 22. 19.75, by L. E. GRUBB