


T.37S. R.7W. W. M.

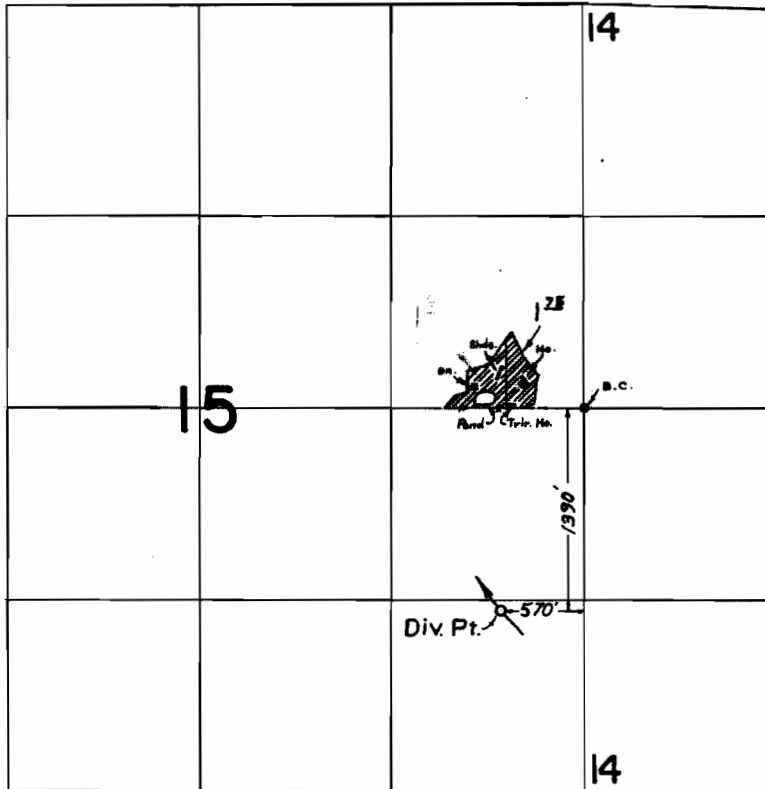

**FINAL PROOF SURVEY**  
UNDER

Application No. 43229 Permit No. 31867  
IN NAME OF

MAYNARD & VIVIAN ZERLAUT

Surveyed MAY 23 1974, by L.E. GOULD