


T.34S., R.6W., W.M.

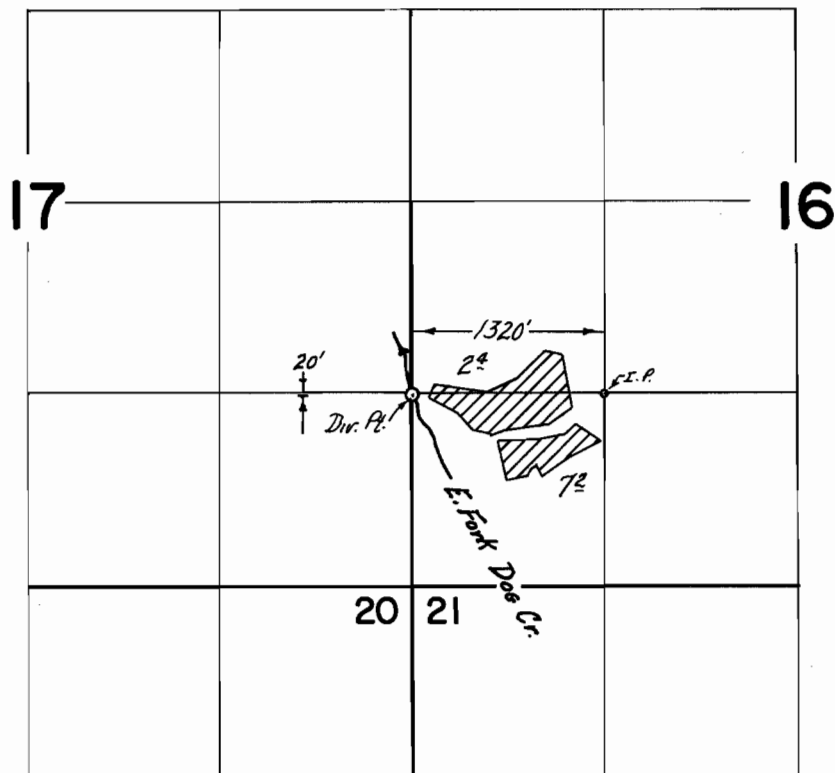

FINAL PROOF SURVEY
UNDER

Application No. 42960 Permit No. 32095
IN NAME OF
GUY CRITESER

Surveyed 12 Sept. 19 72, by D. Noray