


T.34S., R.6W., W.M.

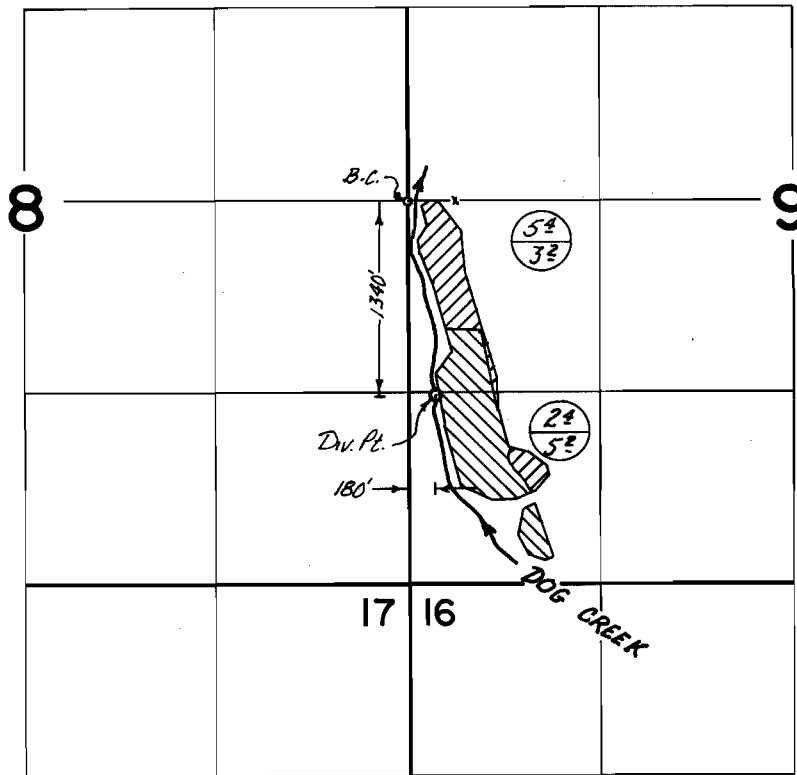

FINAL PROOF SURVEY UNDER

Application No. 42961 Permit No. 32096
IN NAME OF

LEROY W. CRITESER

Surveyed 12 Sept. 1972, by D. Noroy