


T. 36 S. R. 5 W. W.M.

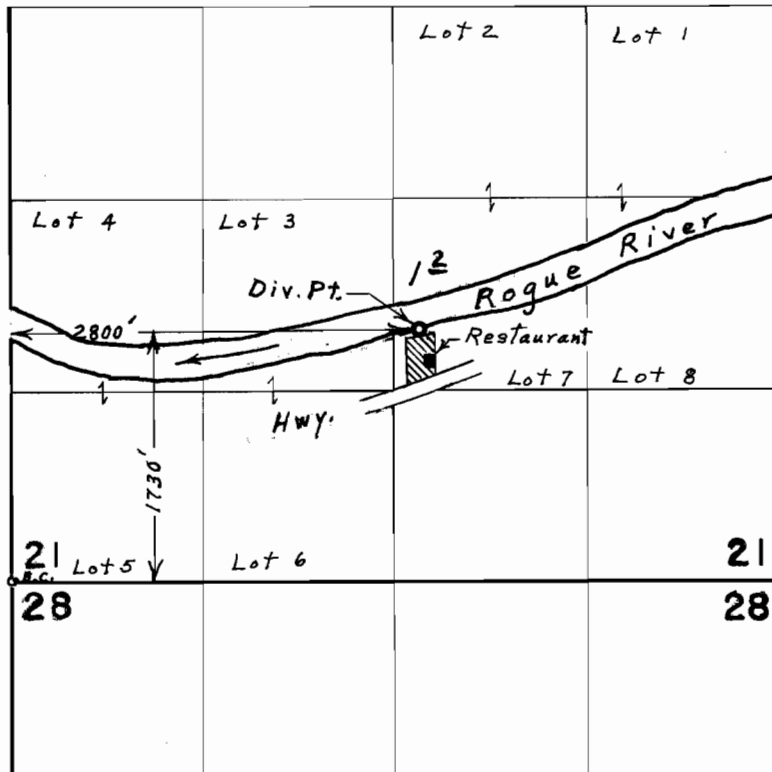

FINAL PROOF SURVEY
UNDER

Application No. 44619 Permit No. 33384
IN NAME OF

JOHN W. RIDLEY

Surveyed April 23, 1974, by L. E. Gould