


T.38S.,R.5W.,W.M.

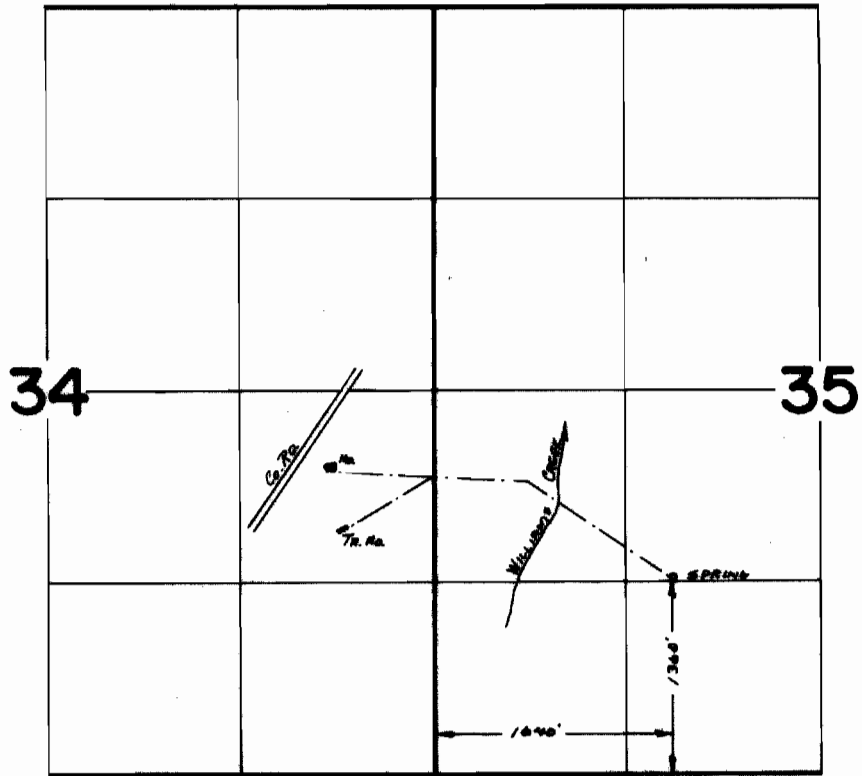

FINAL PROOF SURVEY
UNDER

Application No. 47873... Permit No. 35670...
IN NAME OF

.....CLIFF C. MERRILL.....

Surveyed SEPT. 19 1974, by ...L. TOLL.....