


T. 33 S. R. 6 W. W.M.

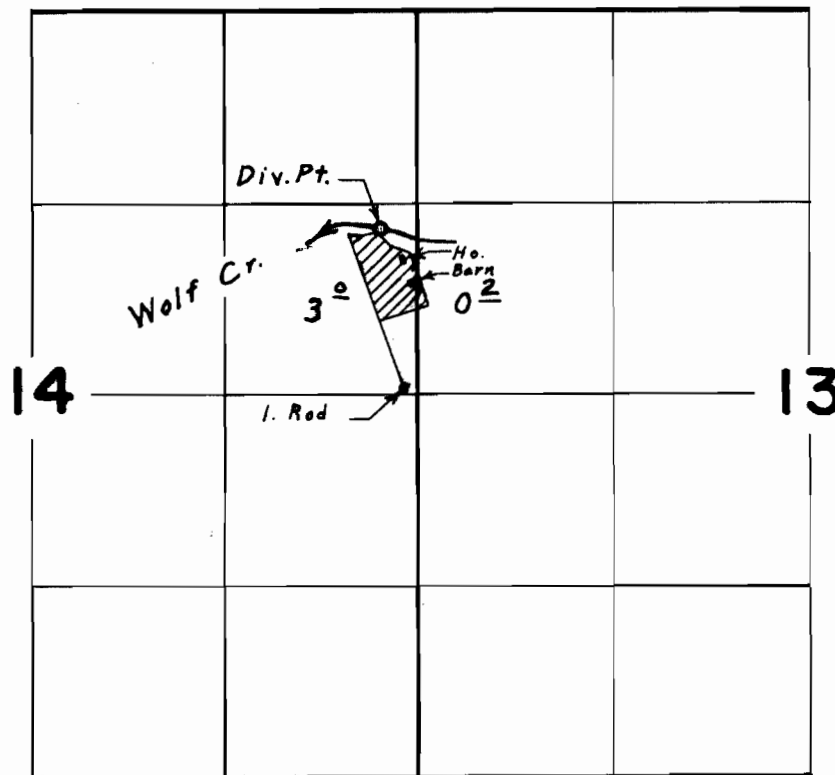

Div. Pt. located 1500' S. & 250' W. from N.E. Cor. Sec. 14

FINAL PROOF SURVEY
UNDER

Application No. 49062 Permit No. 36808
IN NAME OF

WILLIAM DeWITT

Surveyed April 26, 1974, by L. E. Gould