


T. 15 S. R. 4 W. W.M.

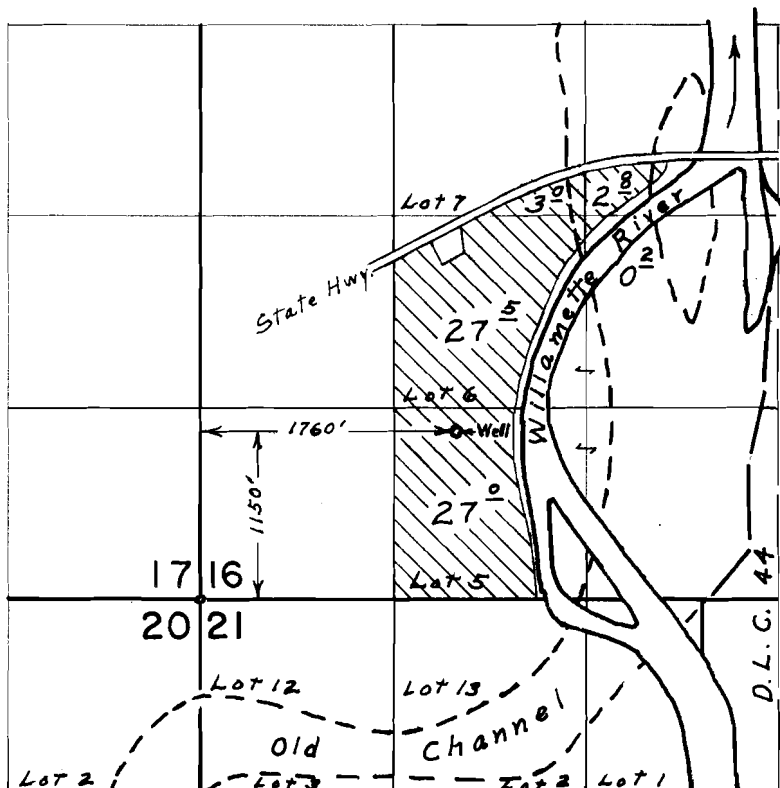

FINAL PROOF SURVEY

UNDER

Application No. G-4458 Permit No. G-4201

IN NAME OF

JAMES F. LEMAN

Surveyed June 3, 1970, by L. E. Gould