


T.15S.,R.4W.,W.M.

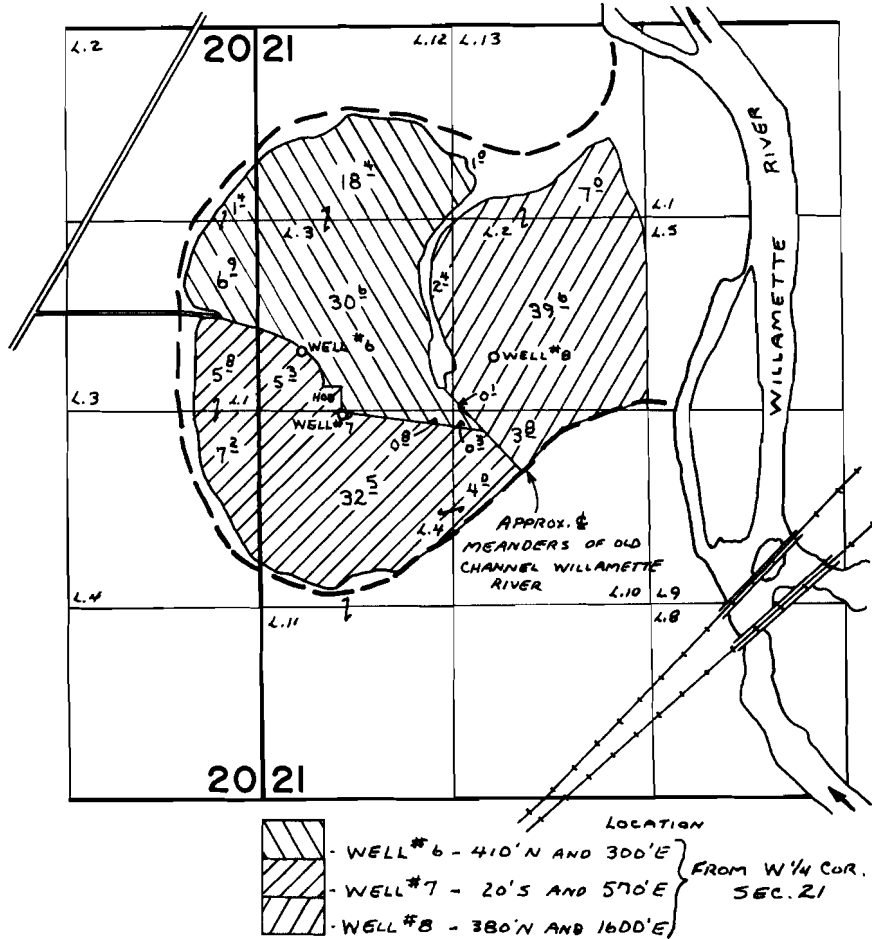

FINAL PROOF SURVEY UNDER

Application No. G-4459 Permit No. G-4202
IN NAME OF

JAMES F. LEMAN

Surveyed Q. S. 18. 1974, by L. Tall