


T.16 S. R.9 W. W.M.

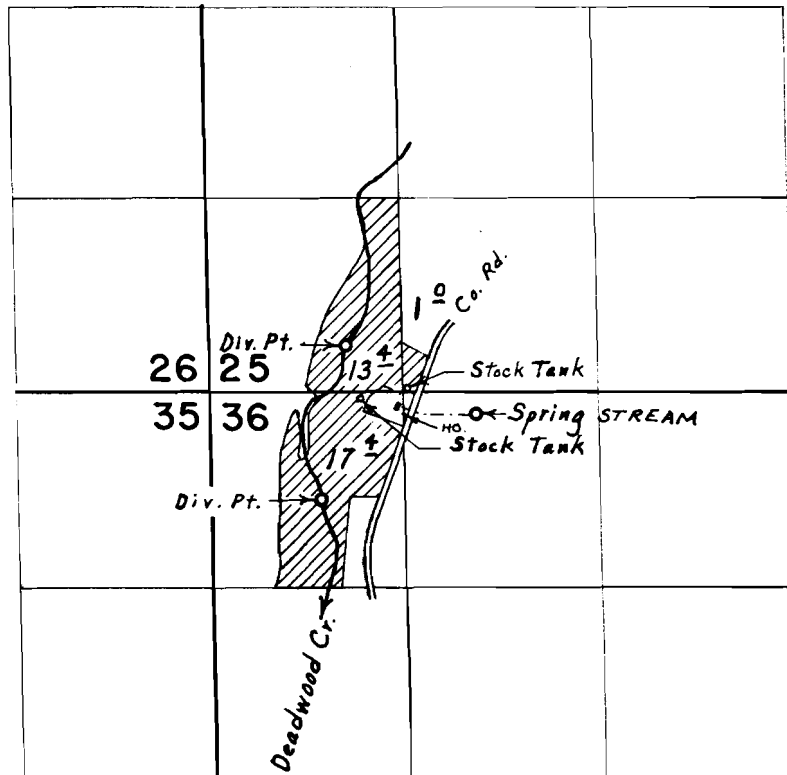

Div. Pts. located: Str., 320' N. & 940' E.; 750' S. & 760' E.;
Spring, 150' S. & 1820' E., all from S. W. Cor. Sec. 25

FINAL PROOF SURVEY UNDER

Application No. 40307 41369 Permit No. 30063 30902
IN NAME OF

GARY W. SEIDEL

Surveyed July 11, 1974, by L. E. Gould