


T.20S. R.2W. W.M.

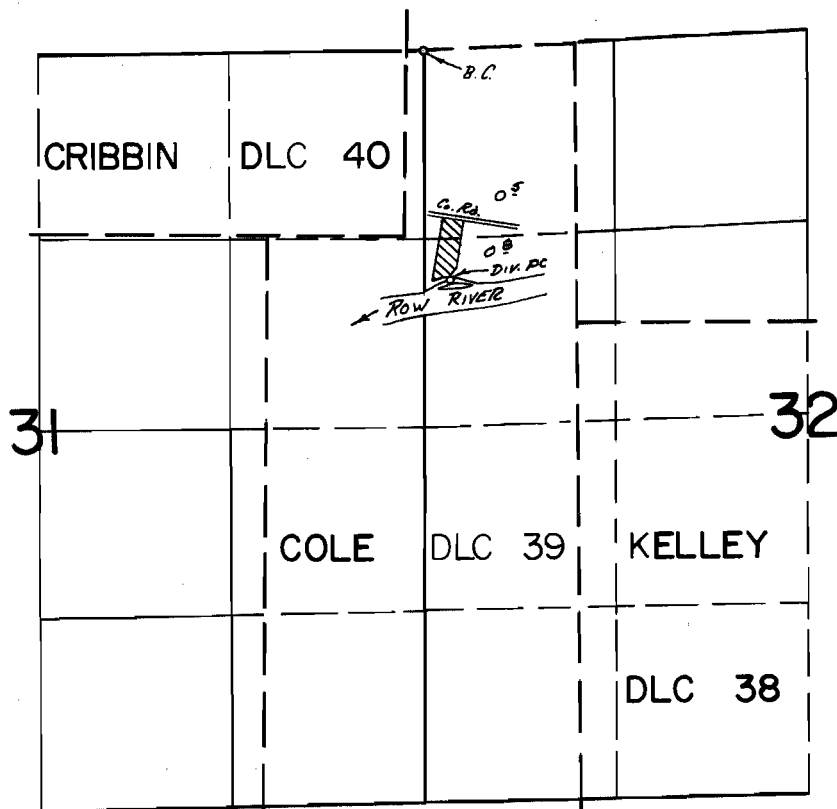

Div. Pl. Loc. 1580' S & 160' E FROM NW Cor. SEC. 32

FINAL PROOF SURVEY
UNDER

Application No. 44458. Permit No. 33252...
IN NAME OF

BRADLEY BRADEN

Surveyed Aug. 15. 1974, by D. M. NORBY.