


T.19S.R.1W.W.M.

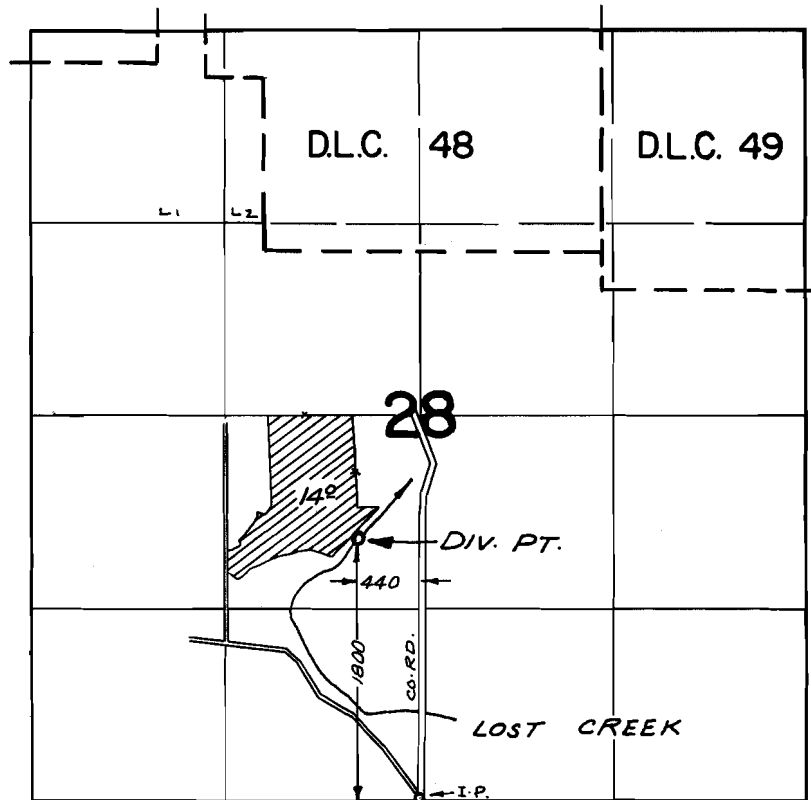

FINAL PROOF SURVEY
UNDER

Application No. 44472 Permit No. 33263
IN NAME OF

ROBERT E. TYLER

Surveyed MAY 8, 1974, by R. MUCKEN