


T.21S.,R.2W.,W.M.

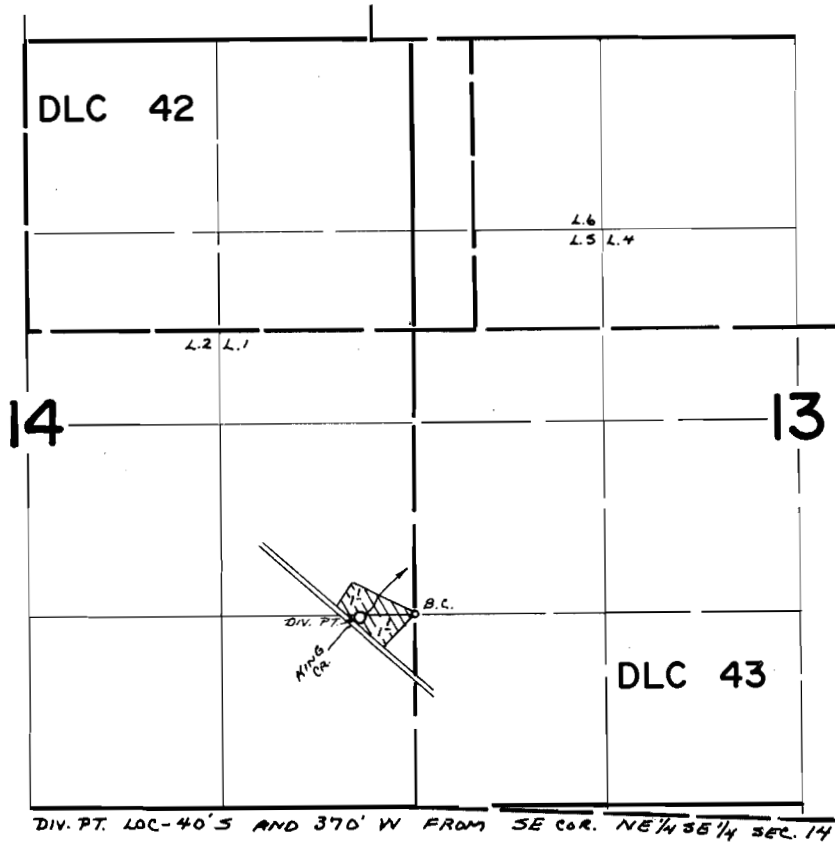

FINAL PROOF SURVEY UNDER

Application No. 44661... Permit No. 33440...
IN NAME OF

.....STEVE THEISS.....

Surveyed Aug. 15, 1974, by D. NORBY.....