


T.19&20S. R.1W. W.M.

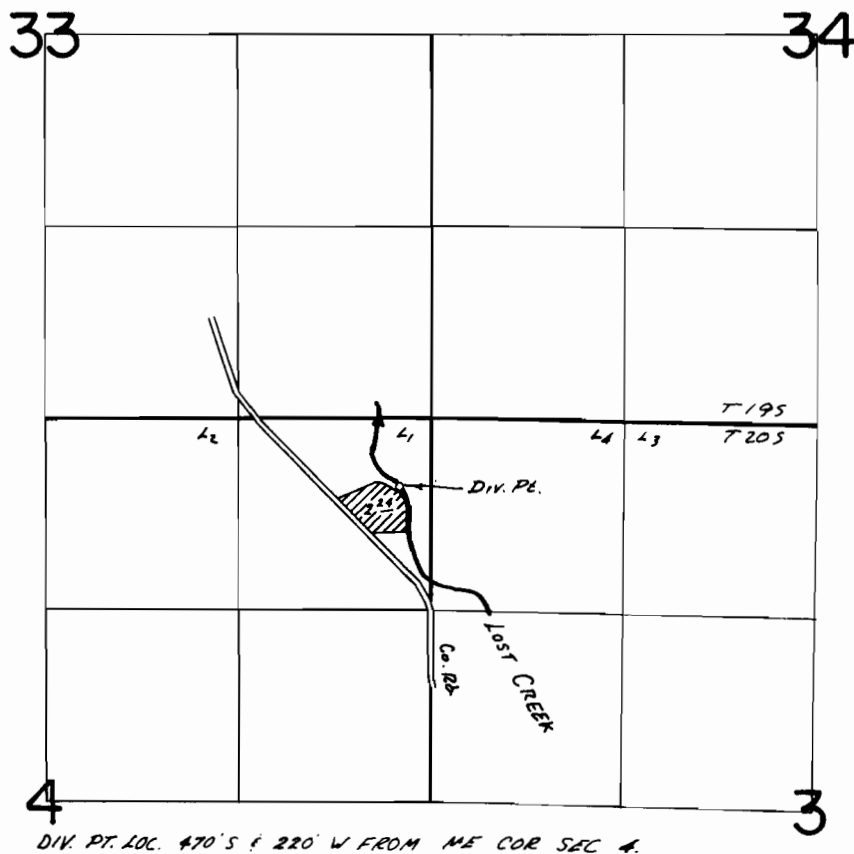

FINAL PROOF SURVEY
UNDER

Application No. 45276 Permit No. 33685
IN NAME OF

JOE O. & LOUELLA CHAFFIN

Surveyed Aug. 16 1974, by D. M. NORBY