


T.21S.,R.3W.,W.M.

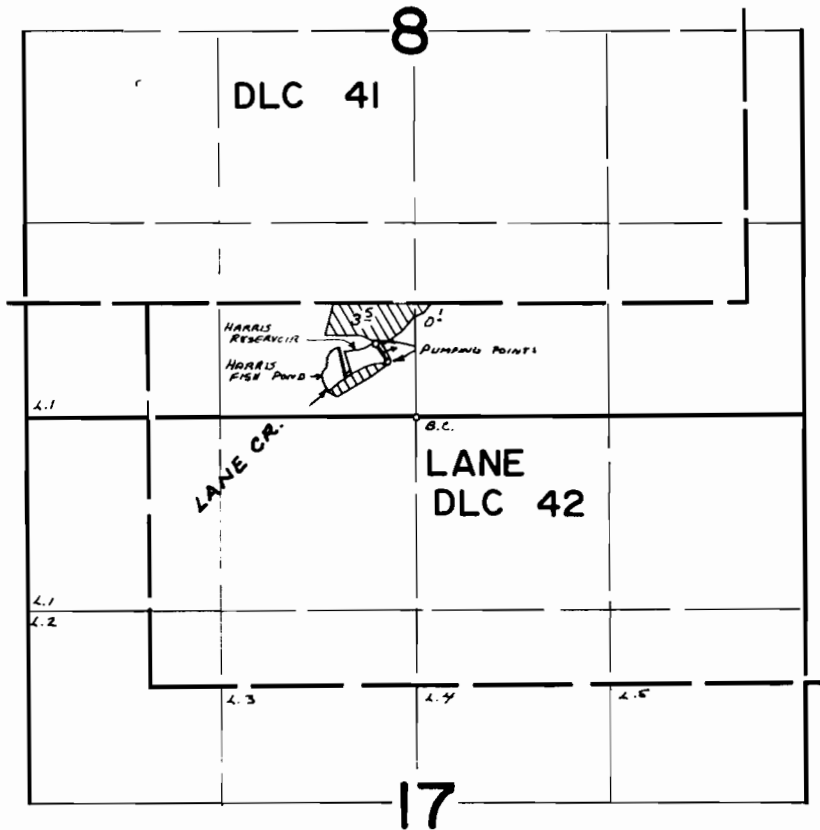

HARRIS FISH POND DAM - 360' N AND 500' W }
HARRIS RESERVOIR DAM - 420' N AND 230' W } FROM S¹/₄ COR. SEC. 8

FINAL PROOF SURVEY
UNDER

R-45875 R-5451
R-45876 R-5452
Application No. 45877... Permit No. 34248...
IN NAME OF

..... FRED HARRIS

Surveyed Aug. 13, 1974, by D. NORBY.....