


T.21S.,R.3W.,W.M.

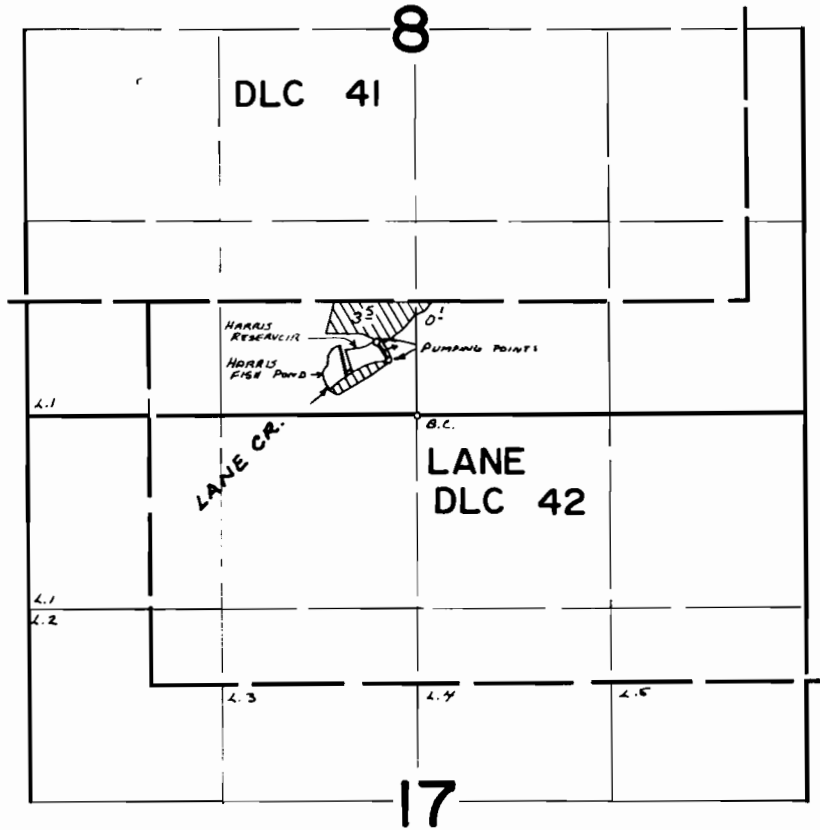

HARRIS FISH POND DAM - 360' N AND 500' W }
 HARRIS RESERVOIR DAM - 420' N AND 230' W } FROM S 1/4 COR. SEC. 8

FINAL PROOF SURVEY UNDER

R-45875 R-5451
 R-45876 R-5452
 Application No. 45877 Permit No. 34248
 IN NAME OF

FRED HARRIS

Surveyed Aug. 13, 1974, by D. NOBBY