


# T.21S.,R.3W.,W.M.

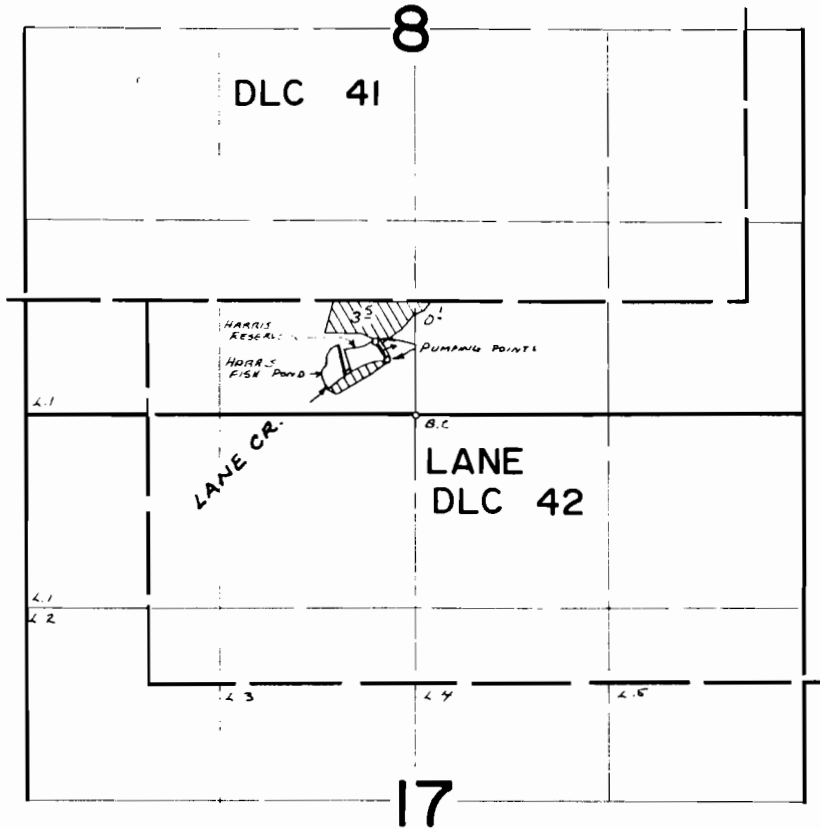

HARRIS FISH POND DAM - 360' N AND 500' W }  
HARRIS RESERVOIR DAM - 420' N AND 230' W } FROM S 1/4 COR. SEC. 8

## FINAL PROOF SURVEY UNDER

R-45875                      R-5451  
R-45876                      R-5452  
Application No. 45877    Permit No. 34248  
IN NAME OF

FRED HARRIS

Surveyed Aug. 13, 1974, by D. NORBY