


T.20S. R.3W. W.M.

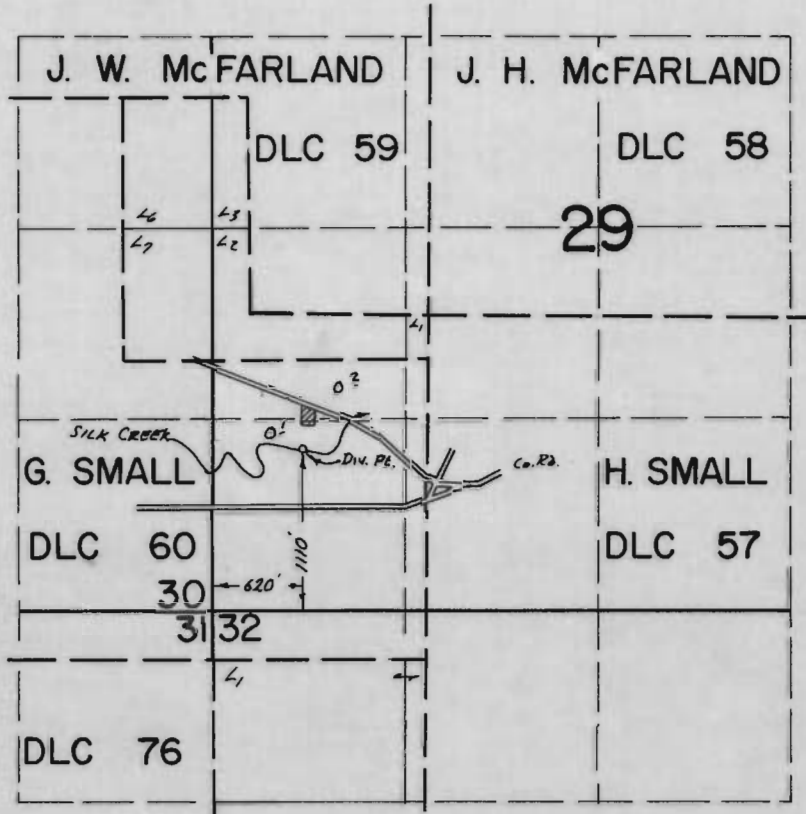

FINAL PROOF SURVEY
UNDER

Application No. 47763 Permit No. 35707
IN NAME OF

VIOLA A. DeHAVEN & ESTATE OF EDWARD E. DeHAVEN

Surveyed Aug. 12, 1974, by D. M. NORBY.