


T.19S. R.1W. W.M.

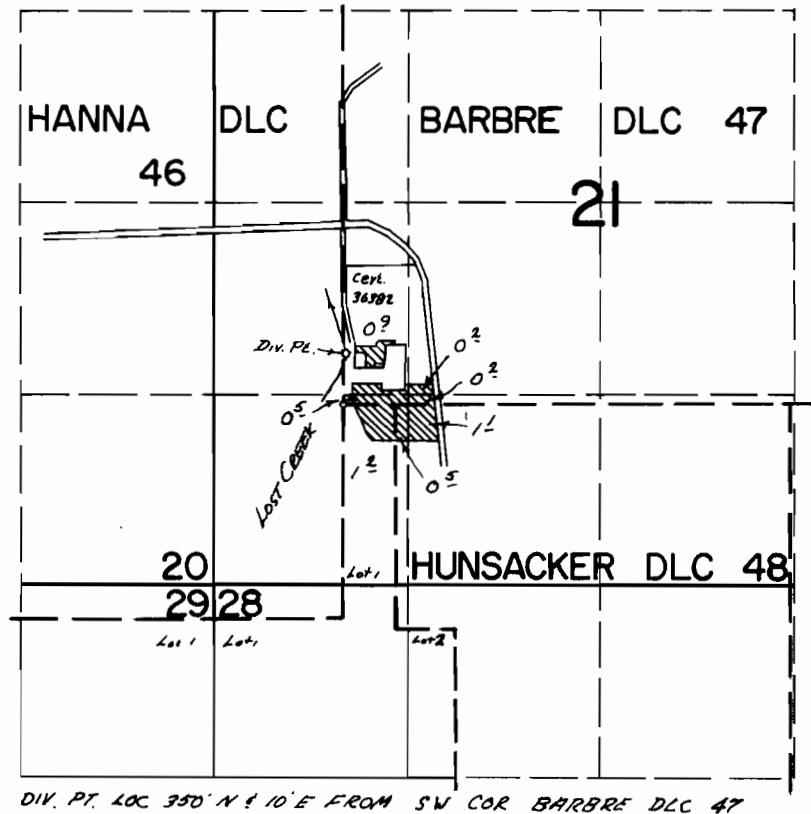

FINAL PROOF SURVEY
UNDER

Application No. 48023 Permit No. 36015.....
IN NAME OF

DARYL B. HOBER

Surveyed Aug...16.. 19.74., by D...M...NORBY...