


T.I.S.R.IOW.W.M.

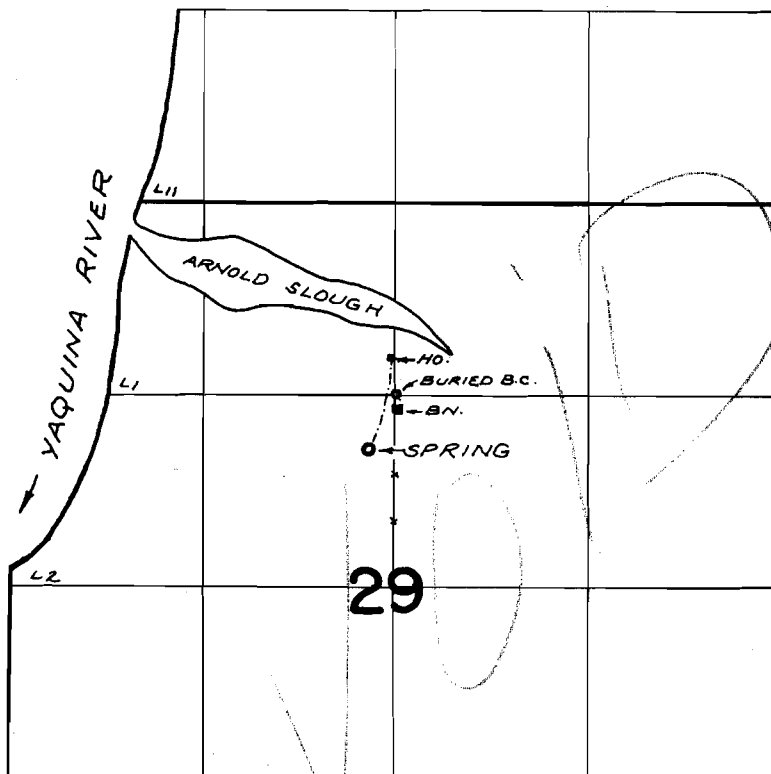

SPRING LOC: 370'S. & 180'W. FROM N.E. CO.R. SE $\frac{1}{4}$ NW $\frac{1}{4}$ SEC. 29

FINAL PROOF SURVEY
UNDER

Application No. 40469 Permit No. 30212
IN NAME OF

DARRAL JOHNSON

Surveyed AUG. 26, 1974, by R. MUCKEN