


T.12S. R.11W. W.M.

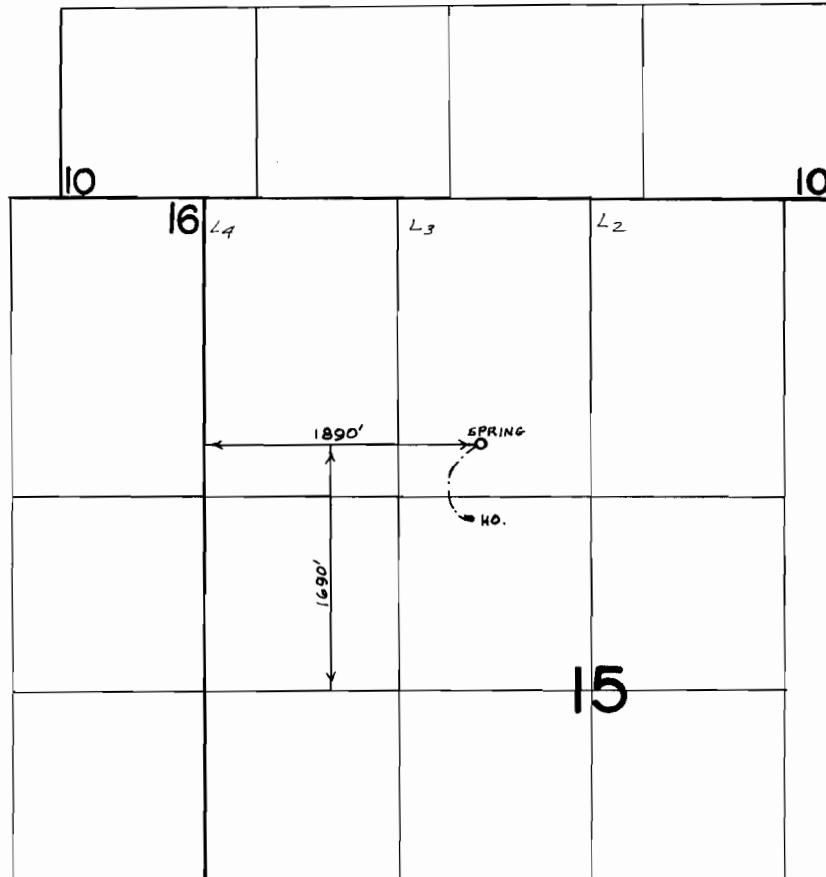

FINAL PROOF SURVEY
UNDER

Application No. 42930 Permit No. 32075
IN NAME OF

WILLIAM WOLKAU

Surveyed AUG. 21 1974, by D. NORBY