


T.10S.R.8 W.W.M.

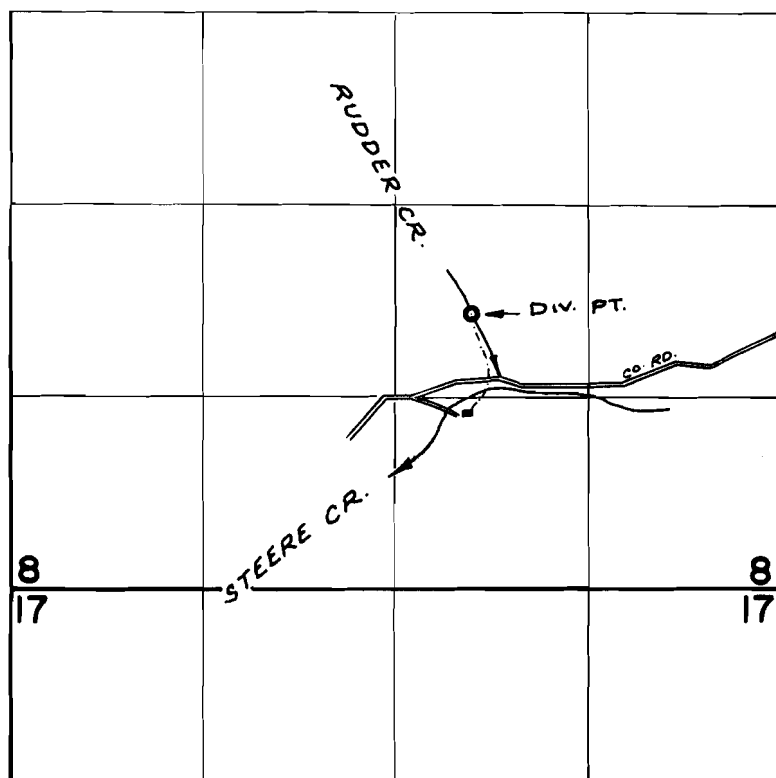

DIV. PT. LOC: 1890' N. & 2120' W. FROM S.E. COR. SEC. 8

FINAL PROOF SURVEY
UNDER

Application No. 45507 Permit No. 34137
IN NAME OF

HATTIE HALL &/OR MARY JANE ROBB

Surveyed AUG. 30, 1974, by R. MUCKEN