


T.12S. R.11W. W.M.

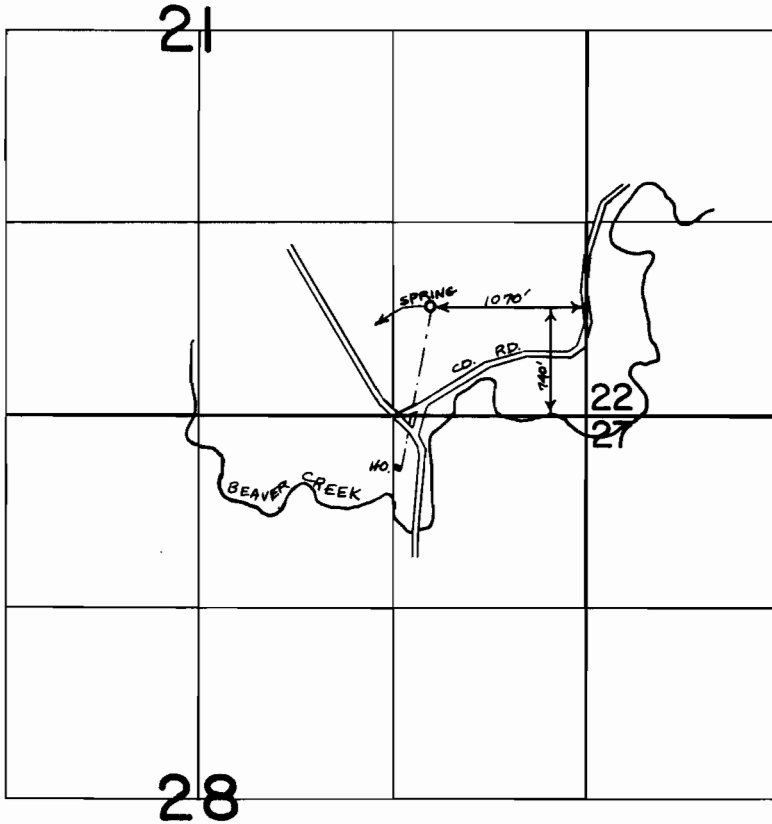

FINAL PROOF SURVEY
UNDER

Application No. 46135 ... Permit No. 34467...
IN NAME OF

FLORENCE I. HALLOWELL

Surveyed AUG. 21 1974, by D. NORBY