


T.10S.R.8W.W.M.

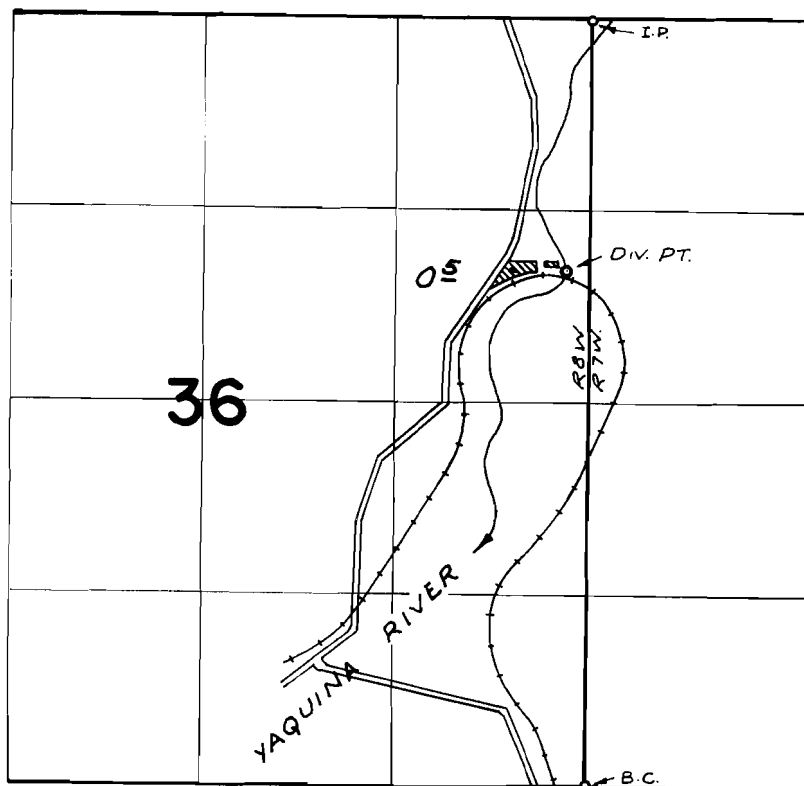

DIV. PT. LOC: 1730'S. & 170'W. FROM N.E. COR. SEC. 36

FINAL PROOF SURVEY
UNDER

Application No. 47332 Permit No. 35458
IN NAME OF

MR. & MRS. OTTO J. BODIE

Surveyed AUG. 30, 1974, by R. MUCKEN