


T. 6S. R. 10W. W.M.

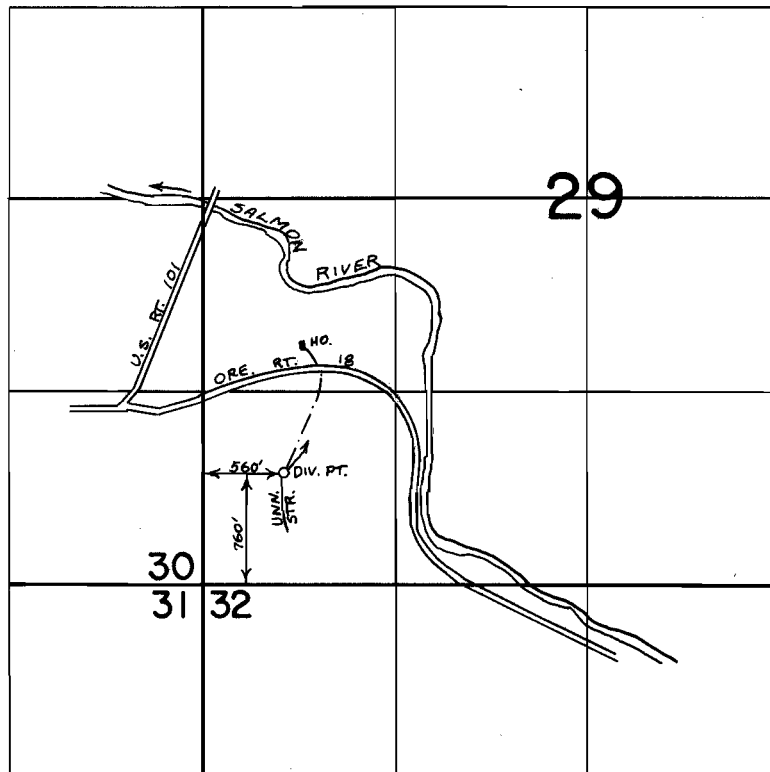

FINAL PROOF SURVEY
UNDER

Application No. 48286 Permit No. 36263
IN NAME OF

EDWIN J. AASEN

Surveyed JULY 19 1974, by D. NORBY