


T.I.S.R.I.W.W.M.

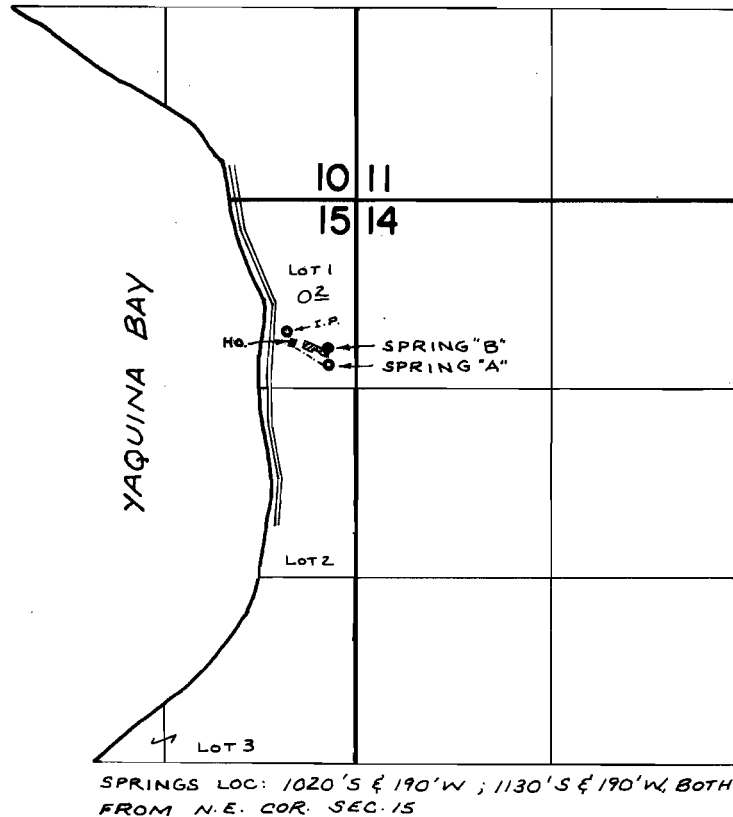

FINAL PROOF SURVEY
UNDER

Application No. 49933 Permit No. 36789
IN NAME OF

S. E. & KATHRYN E. TEDLOCK

Surveyed AUG. 26, 1974, by R. MUCKEN